

Wayne  
M74  
9-12-69

MISSISSIPPI  
BOARD OF WATER COMMISSIONERS CODED  
416 North State Street  
Jackson, Mississippi 39201

CODED

WATER WELL DRILLERS LOG


Sept 12 1969 Robert Drilling & Pump Wayne  
 (date well completed) (firm name) (county well located)

LANDOWNER: <u>William Dean</u>	description of formations encountered	from	to
<u>At 1 Waynesboro Miss</u> (mailing address)	<u>red clay</u>	<u>0</u>	<u>8</u>
WELL LOCATION: sec <u>22</u> T <u>8</u> N R <u>8</u> E S W <u>8</u> miles <u>west</u> of <u>Waynesboro</u> (distance) (direction) (nearest town)	<u>sand &amp; shells</u> <u>stagnant chack</u>	<u>8</u>	<u>86</u>
WELL PURPOSE: <u>Home</u> (home, irrigation, municipal, industrial)	<u>5' 1/4" 7 slot S.S. test in</u> <u>well, packer</u>		
WELL COMPLETION DATA:	<u>4 1/2" 1" deep pipe</u>		
(1) diameter (inches) <u>2"</u>			
(2) total depth (feet) <u>86'</u>			
(3) static water level (feet) <u>36</u> <u>below</u> top of ground.			
(4) casing <u>steel</u> , <u>8 1/2'</u> (material) (depth)			
<u>2"</u> (size) if telescope see back.			
(5) screen <u>5'</u> , <u>81</u> (length) (depth to top)			
<u>1 1/4"</u> , <u>7 slot S.S.</u> (size) (material)			
(6) pump <u>3/4</u> , <u>8</u> (HP) (yield gpm)			
<u>elec.</u> (type power)			
(7) electric log <u>no</u> (yes or no)			
(organization running log)			
(8) how well bottom plugged <u>flush ground</u>			
DRILLERS REMARKS:	SEP 24 1969		

MISS. RD. OF  
REGISTERED COMM.

If well telescopes please  
sketch and show depths.

GROUND LEVEL

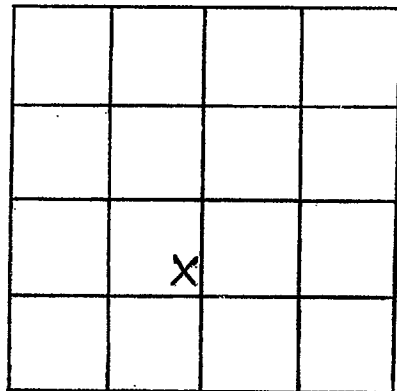

SECTION 22

Please indicate well location X.

ADDITIONAL INFORMATION

If more than one screen,  
show locations of each on sketch.