

WAYNE

M 76

10-13-69

MISSISSIPPI
 BOARD OF WATER COMMISSIONERS
 416 North State Street
 Jackson, Mississippi 39201

CODED

WATER WELL DRILLERS LOG

Oct 13 1969
date well completed

Porta Drilling Co.
firm name

Wayne
county well located

LANDOWNER: Nancy Anderson

description of formations encountered

from

to

241 Haynesboro Miss
(mailing address)

soft clay	0	10
Chalk sand	10	88
rock	88	89
Chalk	89	115
rough sand rock	115	118
stiff chalk	118	186
coarse sand	186	225
blue chalk	225	270
rock strata	270	295
blue chalk	295	401
Vegetating limestone	401	425

WELL LOCATION:

sec 13 T 20 N R 8 E S
5 miles west of Haynesboro
(distance) (direction) (nearest town)

WELL PURPOSE: home
(home, irrigation, municipal, industrial)

WELL COMPLETION DATA:

- (1) diameter (inches) 4"
- (2) total depth (feet) 425'
- (3) static water level (feet) 183' below top of ground
- (4) casing steel 402' (material) (depth)
4" (size) If telescope see back.
- (5) screen none used (length) (depth to top)
(size) (material)
- (6) pump 2 (HP) 20 (yield gpm)
elec. (type power)
- (7) electric log no (yes or no)
(organization running log)
- (8) how well bottom plugged open

240' 1/4" diam. pipe


NOV 1 1969

REC'D MISSISSIPPI BOARD OF WATER COMMISSIONERS

DRILLERS REMARKS:

If well telescopes please sketch and show depths.

GROUND LEVEL

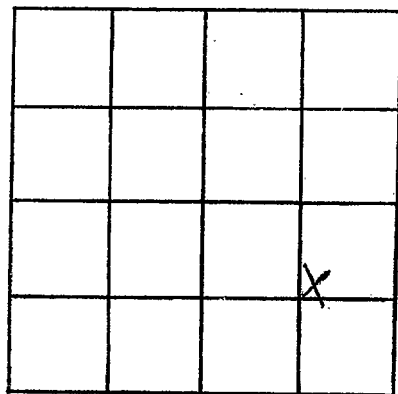

SECTION 13

Please indicate well location X.

ADDITIONAL INFORMATION

If more than one screen,
show locations of each on sketch.