

Wayne
M 77
1-15-70

MISSISSIPPI
BOARD OF WATER COMMISSIONERS
416 North State Street
Jackson, Mississippi 39201

CODED

CODED

WATER WELL DRILLERS LOG

1.15 1970 date well completed
Ray V. Westwater, Inc. firm name
Wayne county well located

LANDOWNER:	description of formations encountered	from	to
Richard Pitts Rt 1	Clay	0	15
Waynesboro Miss (mailing address)	Sandy Clay	15	80
	Pond	80	92

WELL LOCATION:
sec. 2 T 8 N R 8 E
S W
2.0 miles west of Laurel Miss
(distance) (direction) (nearest town)

WELL PURPOSE: home
(home, irrigation, municipal, industrial)

WELL COMPLETION DATA:

(1) diameter (inches) 2

(2) total depth (feet) 92

(3) static water level (feet) 35 below top of ground

(4) casing Galv 87
(material) (depth)

(size) If telescope see back.

(5) screen 87
(length) (depth to top)

1/4" St Steel
(size) (material)

(6) pump 10
(HP) (yield gpm)

Res
(type power)

(7) electric log No
(yes or no)

(organization running log)

(8) how well bottom plugged wash water


DRILLERS REMARKS:

JAN 26 1970

MISS. BD. OF
WATER COMM.

If well telescopes please sketch and show depths.

GROUND LEVEL

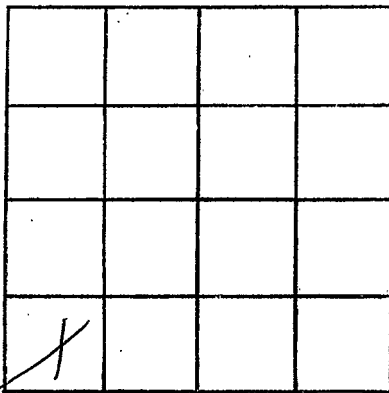

SECTION 2

Please indicate well location X.

ADDITIONAL INFORMATION

If more than one screen,
show locations of each on sketch.