

Wayne  
M 48  
2-5-70

MISSISSIPPI  
BOARD OF WATER COMMISSIONERS  
416 North State Street  
Jackson, Mississippi 39201

CODED

WATER WELL DRILLERS LOG

2-5 1970 Roy West water wells wayne  
date well completed firm name county well located

LANDOWNER: Bill Stegson  
Rt 1  
Waynesboro Miss  
(mailing address)

description of formations encountered	from	to
<u>Clay</u>	<u>0</u>	<u>8</u>
<u>sand</u>	<u>8</u>	<u>23</u>

WELL LOCATION:  
sec. 23 T 8 N R 8 E  
3 miles W of Best Pass  
(distance) (direction) (nearest town)

WELL PURPOSE: home  
(home, irrigation, municipal, industrial)

- WELL COMPLETION DATA:
- (1) diameter (inches) 2
  - (2) total depth (feet) 23 ft
  - (3) static water level (feet) 8 below above top of ground.
  - (4) casing Galv 18  
(material) (depth)  
(size) if telescope see back.
  - (5) screen 5 18  
(length) (depth to top)  
1/4 St Steel  
(size) (material)
  - (6) pump 1/2 5  
(HP) (yield gpm)  
Rea  
(type power)
  - (7) electric log No  
(yes or no)

(organization running log)  
(8) how well bottom plugged wash hole


DRILLERS REMARKS:

FEB 27 1970

MISS. Bd. OF WATER COMMISSIONERS

If well telescopes please sketch and show depths.

GROUND LEVEL

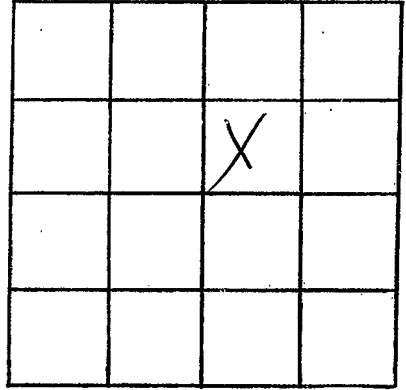

SECTION 23

Please indicate well location X.

ADDITIONAL INFORMATION

If more than one screen,  
show locations of each on sketch.