

Wayne
M 79
2-18-70

MISSISSIPPI
BOARD OF WATER COMMISSIONERS
416 North State Street
Jackson, Mississippi 39201

CODED

WATER WELL DRILLERS LOG

2-18-1970 date well completed
Ray West water wells Wayne firm name
Wayne county well located

LANDOWNER: Jerry Bayles RT 1 Waynesboro (mailing address)	description of formations encountered Sandy clay clay	from 0 16 70	to 16 70 91
--	---	-----------------------	----------------------

WELL LOCATION:
sec. 5 T 8 N R 8 W
16 miles E of Laurel
(distance) (direction) (nearest town)

WELL PURPOSE: Check house
(home, irrigation, municipal, industrial)

- WELL COMPLETION DATA:
- (1) diameter (inches) 2
 - (2) total depth (feet) 91
 - (3) static water level (feet) 40 below above top of ground.
 - (4) casing galv 86 (material) (depth)
 - (size) If telescope see back.
 - (5) screen 5 ft 86 (length) (depth to top)
1/4" St Steel (size) (material)
 - (6) pump 1 8 (HP) (yield gpm)
REA (type power)
 - (7) electric log 70 (yes or no)

(organization running log)
(8) how well bottom plugged wash valve


FEB 27 1970

DRILLERS REMARKS:

MISS. BD. OF
WATER

If well telescopes please sketch and show depths.

GROUND LEVEL

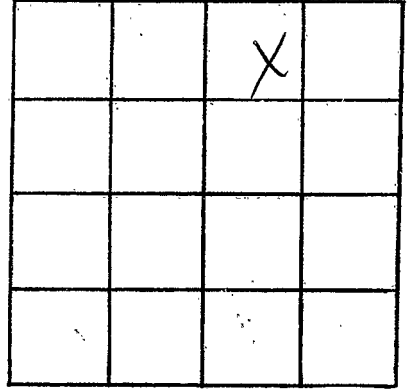

SECTION 5

Please indicate well location X.

ADDITIONAL INFORMATION

If more than one screen,
show locations of each on sketch.