

Wayne Co  
M 82  
4-3-70

MISSISSIPPI  
BOARD OF WATER COMMISSIONERS  
416 North State Street  
Jackson, Mississippi 39201

CODED

WATER WELL DRILLERS LOG

April 3 1970 Roy V Wet Waterwell Wayne  
date well completed firm name county well located

LANDOWNER: Weyl Williams

Rt 1  
Waynesboro  
(mailing address)

description of formations encountered

from to

red clay 0 10  
Sandy Clay 10 20  
Sand 20 70  
Sandy clay 20 90  
Sand 90 110

WELL LOCATION:

sec. 3 T. 8 N. R. 8 E  
S W  
12 miles W of Waynesboro  
(distance) (direction) (nearest town)

WELL PURPOSE: Home  
(home, irrigation, municipal, industrial)

WELL COMPLETION DATA:

- (1) diameter (inches) 2
- (2) total depth (feet) 110
- (3) static water level (feet) 70 below above top of ground.
- (4) casing galv 105  
(material) (depth)  
(size) If telescope see back.
- (5) screen 5 105  
(length) (depth to top)  
1 1/4 st steel  
(size) (material)
- (6) pump 1 7  
(HP) (yield gpm)  
R&A  
(type power)
- (7) electric log No  
(yes or no)

(organization running log)

(8) how well bottom plugged wash hole

DRILLERS REMARKS:


APR 23 1970

MISS. BD. OF  
WATER COMM.

CODED

If well telescopes please sketch and show depths.

GROUND LEVEL

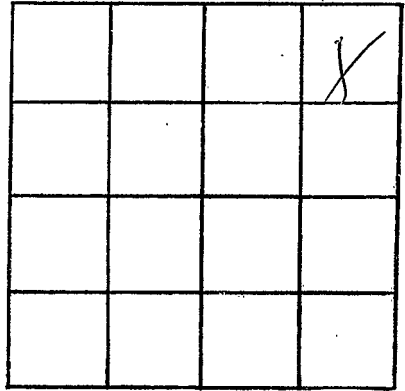

SECTION 3

Please indicate well location X.

ADDITIONAL INFORMATION

If more than one screen, show locations of each on sketch.