

WAYNE
M 84
9-26-70

MISSISSIPPI
BOARD OF WATER COMMISSIONERS
416 North State Street
Jackson, Mississippi 39201

CODED

WATER WELL DRILLERS LOG

SEPT. 26 1970 HOLLAND'S WELL SERVICE WAYNE
date well completed firm name county well located

LANDOWNER: JIM MCKENNY	description of formations encountered	from	to
ROUT 1	TOPSOIL	0	2
WAYNESBORO, MISS (mailing address)	RED CLAY	2	6
WELL LOCATION:	WHITE CHALK	6	26
sec. 8 T. 8 S R. 8 E	FINE WHITE SAND	26	27
9 miles WEST of WAYNESBORO (distance) (direction) (nearest town)	WHITE + RED CHALK	27	42
WELL PURPOSE: HOME (home, irrigation, municipal, industrial)	GREY CHALK	42	58
WELL COMPLETION DATA:	BLACK CHALK	58	60
(1) diameter (inches) 2"	MED. WHITE WATER SAND	60	65
(2) total depth (feet) 65'			
(3) static water level (feet) 41' below top of ground.			
(4) casing PLASTIC, 60' (material) (depth)			
2" (size) if telescope see back.			
(5) screen 5' (length) 60' (depth to top)			
2" PLASTIC (size) (material)			
(6) pump 1/2 (HP) 5 (yield gpm)			
ELECT (type power)			
(7) electric log NO (yes or no)			
(organization running log)			
(8) how well bottom plugged B.W.V.			
DRILLERS REMARKS:			


CODED

OCT 5 1970

MISSISSIPPI BOARD OF WATER COMMISSIONERS

If well telescopes please sketch and show depths.

GROUND LEVEL

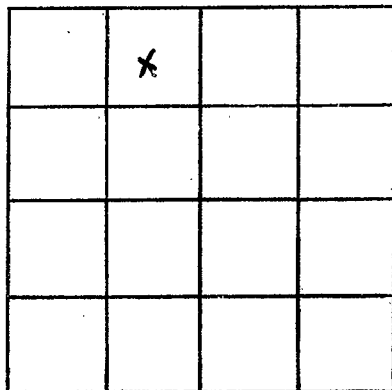

SECTION 8

Please indicate well location X.

ADDITIONAL INFORMATION

If more than one screen, show locations of each on sketch.