

MISSISSIPPI
 BOARD OF WATER COMMISSIONERS
 416 North State Street
 Jackson, Mississippi 39201

CODED

WATER WELL DRILLERS LOG

Wayne
 M 86
 7-2-70

July 2, 1970 Roy V. Westwater & Co. Wayne
 date well completed firm name county well located

LANDOWNER:	description of formations encountered	from	to
Artis Clay	Sandy Clay	0	15
RT 1	Sand	15	40
Waynesboro Miss	Sandy Clay	40	55
(mailing address)	Sand	55	88

WELL LOCATION:
 sec. 2 T. 8 N. R. 8 E
 S W
 10 miles W of Waynesboro
 (distance) (direction) (nearest town)

WELL PURPOSE: Home
 (home, irrigation, municipal, industrial)

- WELL COMPLETION DATA:
- (1) diameter (inches) 2
 - (2) total depth (feet) 88
 - (3) static water level (feet) 45 below top of ground
 - (4) casing galv 83 (material) (depth)
 (size) if telescope see back.
 - (5) screen 5 83 (length) (depth to top)
 1 1/2 St Steel (size) (material)
 - (6) pump 1 8 (HP) (yield gpm)
 R&A (type power)
 - (7) electric log No (yes or no)
 - (8) how well bottom plugged wash hole


CODED

DRILLERS REMARKS:

JUL 28 1970

If well telescopes please sketch and show depths.

GROUND LEVEL

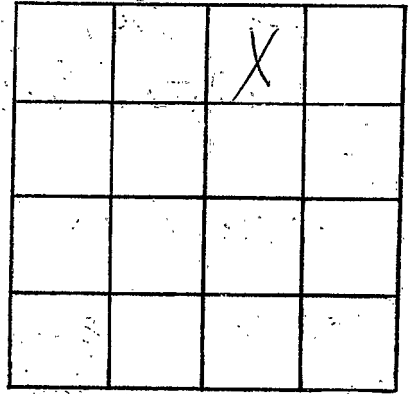

SECTION _____

Please indicate well location X.

ADDITIONAL INFORMATION

If more than one screen, show locations of each on sketch.