

MISSISSIPPI
BOARD OF WATER COMMISSIONERS
416 North State Street
Jackson, Mississippi 39201

CODED

WATER WELL DRILLERS LOG

Wayne
M '87
7-20-70

date well completed 7/20 1970 firm name C.P. Clark county well located Wayne

LANDOWNER: William Fouch

description of formations encountered

from

to

Well #1

Waynesboro Miss
(mailing address)

Clay
Sand

0 23
25 111

WELL LOCATION:

sec. 22 T. 5 N. R. 8 E.
8 miles North of Waynesboro
(distance) (direction) (nearest town)

WELL PURPOSE: Home
(home, irrigation, municipal, industrial)

WELL COMPLETION DATA:

- (1) diameter (inches) 7
- (2) total depth (feet) 111
- (3) static water level (feet) 60 below above top of ground.
- (4) casing Galvalume 106
(material) (depth)

(size) If telescope see back.

- (5) screen 5 106
(length) (depth to top)
- 1 1/4 Solid 5.5.008
(size) (material)

- (6) pump 3/4 10
(HP) (yield gpm)
- 220V 5P.
(type power)

- (7) electric log No
(yes or no)

(organization running log)

- (8) how well bottom plugged Partial

CODED


JUL 22 1970
JUL 22 1970

DRILLERS REMARKS:

MISS. BD. OF
WATER COMM.

If well telescopes please sketch and show depths.

GROUND LEVEL

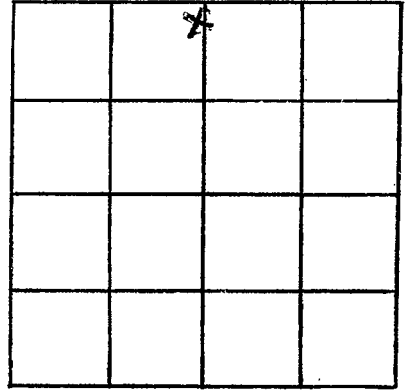

SECTION 22

Please indicate well location X.

ADDITIONAL INFORMATION

If more than one screen,
show locations of each on sketch.