

WAYNE

M 88

10-70

MISSISSIPPI
 BOARD OF WATER COMMISSIONERS
 416 North State Street
 Jackson, Mississippi 39201

CODED

WATER WELL DRILLERS LOG

Oct 1970 date well completed 70 Peoples Drilling Co firm name Wayne county well located

LANDOWNER:

Katherine Cochran

description of formations encountered

from to

Lot 1

Yellow sandy clay

0 36

Richton

Fine yellow sand

36 42

Highway 1000 Miss
(mailing address)

WELL LOCATION:

sec. 11 T. 8 (N) R. 8 (E)
 S (W)
6 miles W of WABO
 (distance) (direction) (nearest town)

Yellow sandy clay
& sand shale

42 80

Yellow sand

80 124

WELL PURPOSE: Home
(home, irrigation, municipal, industrial)

Coarse gravel

124 132

WELL COMPLETION DATA:

- (1) diameter (inches) 2"
- (2) total depth (feet) 132'
- (3) static water level (feet) 95 below above top of ground.
- (4) casing Galv. 126'
(material) (depth)
2" if telescope see back.
(size)
- (5) screen 6' 126'
(length) (depth to top)
2" stainless steel
(size) (material)
- (6) pump NONE
(HP) (yield gpm)

(type power)
- (7) electric log No
(yes or no)

(organization running log)
- (8) how well bottom plugged Back
WASA VALVE

CODED


NOV 23 1970

DRILLERS REMARKS:

MISS. BD. OF
WATER COMM.

If well telescopes please sketch and show depths.

GROUND LEVEL

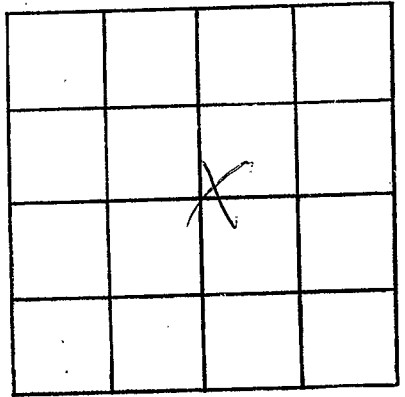

SECTION 11

Please indicate well location X.

ADDITIONAL INFORMATION

If more than one screen, show locations of each on sketch.