

WAYNE
M 89
10-70

MISSISSIPPI
BOARD OF WATER COMMISSIONERS
416 North State Street
Jackson, Mississippi 39201

CODED

WATER WELL DRILLERS LOG

Oct 1970 Kepler Drilling Co Wayne
date well completed firm name county well located

LANDOWNER: K. G. Croger

description of formations encountered from to
Yellow Sandy clay 0 22

Waynesboro, Miss
(mailing address)

Yellow Sand 22 40

WELL LOCATION:
sec. 11 T. 8N R. 8E
6 miles W of WABO
(distance) (direction) (nearest town)

Yellow Sandy clay
Small sand streaks 40 90

Fine Sand 90 130

WELL PURPOSE: Home
(home, irrigation, municipal, industrial)

Coarse sand + gravel 130 142

WELL COMPLETION DATA:
(1) diameter (inches) 2"
(2) total depth (feet) 142'
(3) static water level (feet) 100 below above top of ground.
(4) casing Galv. 142
(material) (depth)
2" If telescope see back.
(size)
(5) screen 5' 142'
(length) (depth to top)
2" stainless steel
(size) (material)
(6) pump 1/2 5
(HP) (yield gpm)
elect.
(type power)
(7) electric log no
(yes or no)
(organization running log)

CODED

(8) how well bottom plugged Back
Wash hole


NOV 23 1970

DRILLERS REMARKS:

AS100-25-05
WATER COMMISSIONERS

If well telescopes please sketch and show depths.

GROUND LEVEL

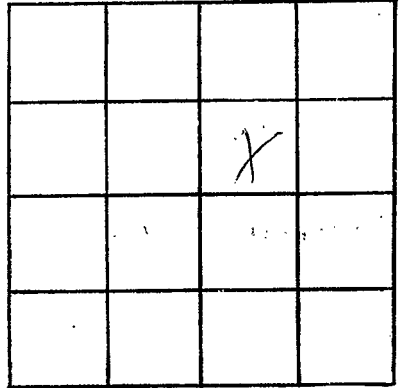

SECTION 11

Please indicate well location X.

ADDITIONAL INFORMATION

If more than one screen, show locations of each on sketch.