

WAYNE
M90
6-29-70

MISSISSIPPI
BOARD OF WATER COMMISSIONERS
416 North State Street
Jackson, Mississippi 39201

CODED

WATER WELL DRILLERS LOG

June 29, 1970 McDonald & Hill Inc Wayne
date well completed firm name county well located


LANDOWNER: <u>Everett Pitts</u> <u>Elvin</u> <u>Rt 1</u>	description of formations encountered	from	to
<u>Waynesboro, Miss</u> (mailing address)	<u>Clay + sand</u>	<u>2</u>	<u>18</u>
WELL LOCATION: sec. <u>3</u> T. <u>8</u> N. R. <u>8</u> E <u>8</u> miles <u>west</u> of <u>Waynesboro</u> (distance) (direction) (nearest town)	<u>Coarse sand</u>	<u>18</u>	<u>65</u>
WELL PURPOSE: <u>home</u> (home, irrigation, municipal, industrial)	CODED		
WELL COMPLETION DATA:			
(1) diameter (inches) <u>2</u>			
(2) total depth (feet) <u>65</u>			
(3) static water level (feet) <u>37</u> below above top of ground.			
(4) casing <u>2' Galv.</u> <u>60</u> (material) (depth)			
<u>no</u> if telescope see back. (size)			
(5) screen <u>5</u> <u>60</u> (length) (depth to top)			
<u>2"</u> <u>brass</u> (size) (material)			
(6) pump <u>1/2</u> <u>10</u> (HP) (yield gpm)			
<u>jet</u> (type of power)			
(7) electric log <u>no</u> (yes or no)			
<u>no</u> (organization running log)			
(8) how well bottom plugged <u>back</u> <u>pressure valve</u>			
DRILLERS REMARKS: <u>none</u>			

DEC 7 1970

MISS. BD. OF
WATER COMM.

If well telescopes please sketch and show depths.

GROUND LEVEL

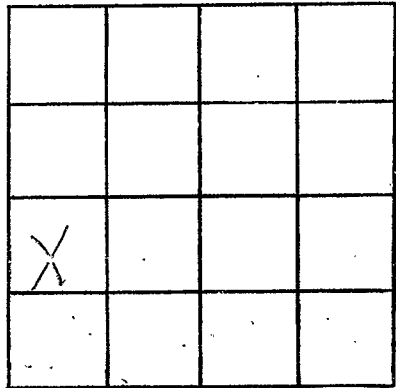

SECTION 8

Please indicate well location X.

ADDITIONAL INFORMATION

If more than one screen,
show locations of each on sketch.