

WAYNE  
M91  
2-11-71

MISSISSIPPI  
BOARD OF WATER COMMISSIONERS  
416 North State Street  
Jackson, Mississippi 39201

**CODED**

WATER WELL DRILLERS LOG

Feb. 11 1971 HOLLAND'S WELL SERVICE WAYNE  
date well completed firm name county well located

LANDOWNER: BERRY DAVIS JR.  
ROUT 3  
WAYNESBORO, MISS.  
(mailing address)

WELL LOCATION:  
sec. 14 T. 2 S. R. 2 E  
8 miles SW of WAYNESBORO  
(distance) (direction) (nearest town)

WELL PURPOSE: HOME  
(home, irrigation, municipal, industrial)

WELL COMPLETION DATA:

(1) diameter (inches) 2"  
(2) total depth (feet) 108  
(3) static water level (feet) 86' (below) above top of ground.  
(4) casing PLASTIC, 78' (material) (depth).  
2" if telescope see back. (size)  
(5) screen 8' 78' (length) (depth to top)  
2" PLASTIC (size) (material)  
(6) pump 1 (HP) 5 (yield gpm)  
ELECT. (type power)  
(7) electric log NO (yes or no)  
(organization running log)  
(8) how well bottom plugged B.W.V.

description of formations encountered	from	to
TOP SOIL	0	1
YELLOW CLAY	1	9
MEDIUM RED SAND	9	86
WHITE SAND	86	96
SOFT LIME ROCK	96	99
COARSE WATER SAND	99	108

**CODED**


MAR 9 1971

MISS. BD. Of  
WATER COMMISSIONERS

DRILLERS REMARKS:

If well telescopes please sketch and show depths.

GROUND LEVEL

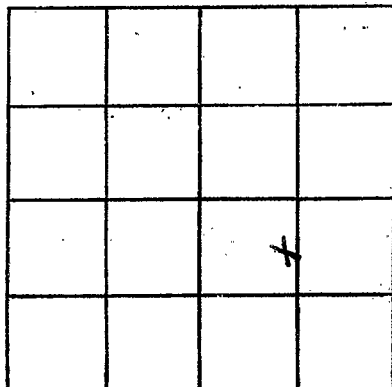

SECTION 14

Please indicate well location X.

ADDITIONAL INFORMATION

If more than one screen, show locations of each on sketch.