

**MISSISSIPPI
BOARD OF WATER COMMISSIONERS**
416 North State Street
Jackson, Mississippi 39201

CODED

WATER WELL DRILLERS LOG

WAYNE
M 92
2-23-71

Feb 23 1971 Port Dalling & Co Wayne
date well completed firm name county well located

LANDOWNER: John E. Gault
Box 17 Wayneboro Miss
(mailing address)

WELL LOCATION:
sec. 1 T. 8 N. R. 9 E.
5 miles W of Waynesboro
(distance) (direction) (nearest town)

WELL PURPOSE: home
(home, irrigation, municipal, industrial)

- WELL COMPLETION DATA:
- (1) diameter (inches) 2"
 - (2) total depth (feet) 110
 - (3) static water level (feet) 83 below top of ground.
 - (4) casing stal 105'
(material) (depth)
2" if telescope see back.
(size)
 - (5) screen 4' 106'
(length) (depth to top)
1 1/2" galv S.S.
(size) (material)
 - (6) pump 1 6
(HP) (yield gpm)
elec.
(type power)
 - (7) electric log no
(yes or no)

(organization running log)

(8) how well bottom plugged
plugged cement

DRILLERS REMARKS:

description of formations encountered	from	to
<u>red clay</u>	<u>0</u>	<u>16</u>
<u>sand + shells</u>	<u>16</u>	<u>25</u>
<u>blue chalk</u>	<u>25</u>	<u>38</u>
<u>sand + iron gravel</u>	<u>38</u>	<u>55</u>
<u>chalk</u>	<u>55</u>	<u>63</u>
<u>iron gravel</u>	<u>63</u>	<u>66</u>
<u>iron sand</u>		
<u>iron gravel</u>	<u>66</u>	<u>105</u>
<u>iron sand</u>	<u>105</u>	<u>110</u>
<u>stagnant water</u>		
<u>still in sand</u>		

4" 1 1/2" galv S.S.
with 1 1/2" 1 1/2" galv
head on well packer
95' 1 1/2" drop pipe


CODED

MAR 12 1971

MISS. BD. OF
WATER COMM.

If well telescopes please sketch and show depths.

GROUND LEVEL

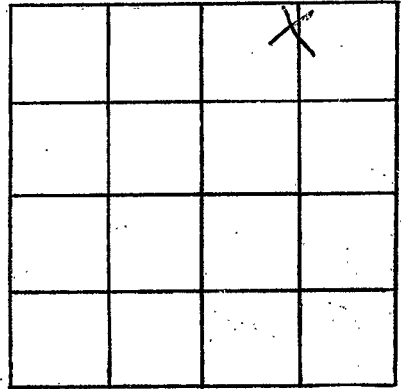

SECTION /

Please indicate well location X.

ADDITIONAL INFORMATION

If more than one screen,
show locations of each on sketch.