

WAYNE
M93
3-18-71

MISSISSIPPI
BOARD OF WATER COMMISSIONERS
416 North State Street
Jackson, Mississippi 39201

CODED

WATER WELL DRILLERS LOG

March 18 1971 Boyle Drilling Wayne
date well completed firm name county well located

LANDOWNER: <u>Larry Buckley</u>	description of formations encountered	from	to
<u>At 1 Hainesboro Mo</u> (mailing address)	<u>sand</u>	<u>0</u>	<u>15</u>
WELL LOCATION:	<u>Chalk & sand</u>	<u>15</u>	<u>45</u>
sec. <u>14</u> T. <u>20</u> N. R. <u>2</u> E.	<u>med sand</u>	<u>45</u>	<u>75</u>
7 miles <u>west</u> of <u>Hainesboro</u>	<u>lim or sand</u>	<u>75</u>	<u>80</u>
(distance) (direction) (nearest town)	<u>sand & chalk</u>	<u>80</u>	<u>85</u>
WELL PURPOSE: <u>dom</u>	<u>med coarse sand</u>	<u>85</u>	<u>96</u>
(home, irrigation, municipal, industrial)	<u>slip on loose</u>		
WELL COMPLETION DATA:	<u>2' of</u>		
(1) diameter (inches) <u>3 1/2"</u>			
(2) total depth (feet) <u>96'</u>	<u>65' 1 1/2" drop pipe</u>		
(3) static water level (feet) <u>41'</u>			
below top of ground			
(4) casing <u>steel</u>			
(material) (depth)			
2' (size) If telescope see back:			
5' (size) 91'			
(5) screen (length) (depth to top)			
2' (size) 1 1/2" (material)			
(6) pump (HP) (yield gpm)			
<u>elec</u>			
(type power)			
(7) electric log (yes or no)			
<u>no</u>			
(organization running log)			
(8) how well bottom plugged <u>elec</u>			
DRILLERS REMARKS:			


CODED

APR - 8 1971

MISS. BD. OF
WATER COMMISSIONERS

If well telescopes please sketch and show depths.

GROUND LEVEL

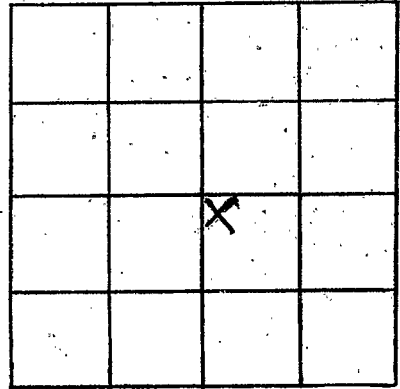

SECTION 14

Please indicate well location X.

ADDITIONAL INFORMATION

If more than one screen, show locations of each on sketch.