

WAYNE
M 94
4-28-71

MISSISSIPPI
BOARD OF WATER COMMISSIONERS
416 North State Street
Jackson, Mississippi 39201

WATER WELL DRILLERS LOG

CODED

april 28 1971 Ray West Water Well Co. Inc. firm name
date well completed county well located

LANDOWNER:
Earnest F Johnson
Rt 1 Waynesboro Miss
(mailing address)

description of formations encountered	from	to
clay	0	5
Dondy clay	5	40
pond	40	110

WELL LOCATION:
sec. 2 T 8 N R 8 E
S W
10 miles W of Waynesboro
(distance) (direction) (nearest town)

WELL PURPOSE: home
(home, irrigation, municipal, industrial)

- WELL COMPLETION DATA:
- (1) diameter (inches) 2
 - (2) total depth (feet) 110
 - (3) static water level (feet) 50 below above top of ground.
 - (4) casing galv 105 (material) (depth)
 - (size) if telescope see back.
 - (5) screen 5 105 (length) (depth to top)
 - 1 1/4 St Steel (size) (material)
 - (6) pump 1 7 (HP) (yield gpm)
 - REA (type power)
 - (7) electric log 710 (yes or no)
 - (organization running log)
 - (8) how well bottom plugged wash water

CODED


MAY 10 1971

DRILLERS REMARKS:

MISS. BD. OF
WATER COMM.

If well telescopes please sketch and show depths.

GROUND LEVEL

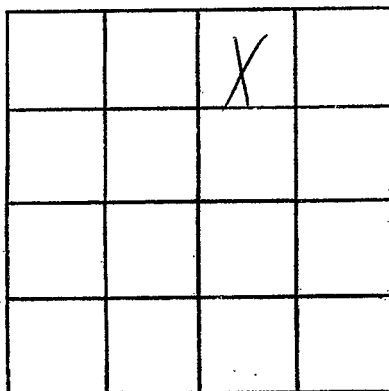

SECTION 2

Please indicate well location X.

ADDITIONAL INFORMATION

If more than one screen,
show locations of each on sketch.