

WAYNE
M 95
6-28-71

MISSISSIPPI
BOARD OF WATER COMMISSIONERS
416 North State Street
Jackson, Mississippi 39201

CODED

WATER WELL DRILLERS LOG

June 28 1971 Ray West Waterworks Wayne
date well completed firm name county well located

LANDOWNER: L. Shute
Rt 1 Box 148 B.B.
Waynesboro Miss
(mailing address)

description of formations encountered	from	to
Clay	0	6
Sandy clay	6	20
Clay	20	85
Sandy clay	85	115
Sand	115	152

WELL LOCATION:
sec. 5 T 8 N R 8 E
S W
(distance) miles (direction) of (nearest town)

WELL PURPOSE: home
(home, irrigation, municipal, industrial)

- WELL COMPLETION DATA:
- (1) diameter (inches) 2
 - (2) total depth (feet) 152
 - (3) static water level (feet) 60 below above top of ground.
 - (4) casing galv 147 (material) (depth)
 - (size) if telescope see back.
 - (5) screen 5 147 (length) (depth to top)
1 1/4 St Steel (size) (material)
 - (6) pump 3/4 5 (HP) (yield gpm)
Kia (type power)
 - (7) electric log NO (yes or no)

CODED

(organization running log)
(8) how well bottom plugged Wash valve


JUL 6 1971

MISS. BD. OF
WATER COMM.

DRILLERS REMARKS:

If well telescopes please sketch and show depths.

GROUND LEVEL

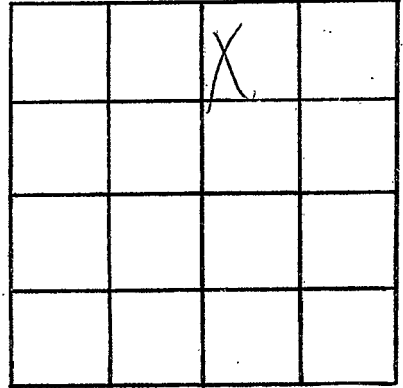

SECTION 5

Please indicate well location X.

ADDITIONAL INFORMATION

If more than one screen,
show locations of each on sketch.