

CODED

WAYNE

M-97

7-13-71

MISSISSIPPI
BOARD OF WATER COMMISSIONERS
416 North State Street
Jackson, Mississippi 39201

CODED

WATER WELL DRILLERS LOG

July 13 1971 Roy V Winst Water Wells Wayne
date well completed firm name county well located

LANDOWNER:	description of formations encountered	from	to
Albert Smith	Clay	0	10
Rt 1 Wayneboro	Sand & clay	10	65
(mailing address)	clay	65	90
WELL LOCATION:	Sand	90	119
sec. 14 T 8 N R 8 E			
20 miles S.E. of Laurel			
(distance) (direction) (nearest town)			
WELL PURPOSE: home			
(home, irrigation, municipal, industrial)			
WELL COMPLETION DATA:			
(1) diameter (inches) 2 in			
(2) total depth (feet) 119			
(3) static water level (feet) 60 below top of ground.			
(4) casing Galv 1 1/4 (material) (depth)			
(size) If telescope see back.			
(5) screen 5 ft 1 1/4 (length) (depth to top)			
1 1/4 St Steel (size) (material)			
(6) pump 1 6 (HP) (yield gpm)			
R&A (type power)			
(7) electric log No (yes or no)			
(organization running log)			
(8) how well bottom plugged wash valve			
DRILLERS REMARKS:			


CODED

AUG 23 1971

MISS. BD. OF
WATER COMMISSIONERS

If well telescopes please sketch and show depths.

GROUND LEVEL

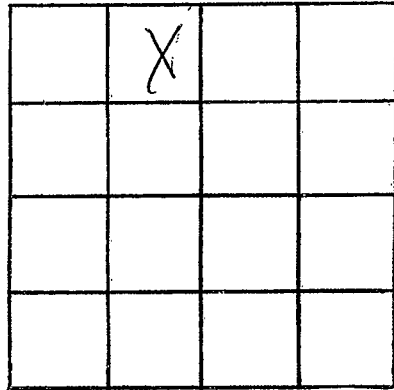

SECTION 14

Please indicate well location X.

ADDITIONAL INFORMATION

If more than one screen,
show locations of each on sketch.