

WAYNE

M-98

7-29-71

MISSISSIPPI BOARD OF WATER COMMISSIONERS 416 North State Street Jackson, Mississippi 39201

WATER WELL DRILLERS LOG

July 29 1971 Roy V West Waterwells Wayne date well completed firm name county well located

LANDOWNER: Buck Ripper Rt 1 Waynesboro (mailing address)

Table with 3 columns: description of formations encountered, from, to. Rows include Clay, Sandy clay, Clay, sandy clay, sand with depth ranges from 0 to 200.

WELL LOCATION: sec. 5 T 8 N R 8 E 1.6 miles E of Laurel (distance) (direction) (nearest town)

WELL PURPOSE: home (home, irrigation, municipal, industrial)

- WELL COMPLETION DATA: (1) diameter (inches) 2 in (2) total depth (feet) 200 (3) static water level (feet) 75 below top of ground. (4) casing plastic, 195 (material) (depth) (5) screen 5 ft, 195 (length) (depth to top) 1 1/4 (size) St Steel (material) (6) pump 1 hp 8 (HP) (yield gpm) R & A (type power) (7) electric log No (yes or no) (8) how well bottom plugged washable


AUG 23 1971

DRILLERS REMARKS:

MISS. BD. OF WATER COMMISSIONERS

If well telescopes please sketch and show depths.

GROUND LEVEL

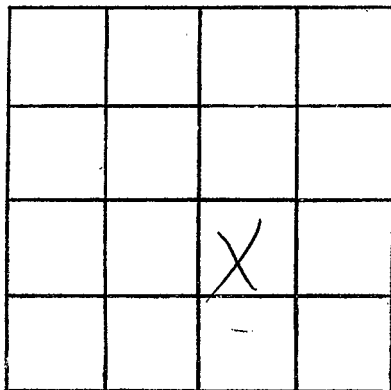

SECTION 5

Please indicate well location X.

ADDITIONAL INFORMATION

If more than one screen,
show locations of each on sketch.