

Wayne
M 101
2-23-72

TM CA
MISSISSIPPI
BOARD OF WATER COMMISSIONERS
416 North State Street
Jackson, Mississippi 39201
MAR 17 1972

CODED
WATER WELL DRILLERS LOG

Feb 23 1972
date well completed
Teeple Water Wells
firm name
Wayne
county well located

LANDOWNER: Sonny Pitts
Rt 1
Waynesboro
(mailing address)

description of formations encountered	from	to
<u>Dowd clay</u>	<u>0</u>	<u>7</u>
<u>Dowd</u>	<u>7</u>	<u>97</u>

WELL LOCATION:
sec. 3 T. 8 N. R. 8 E
15 miles E of Faulk
(distance) (direction) (nearest town)

WELL PURPOSE: home
(home, irrigation, municipal, industrial)


- WELL COMPLETION DATA:
- (1) diameter (inches) 2
 - (2) total depth (feet) 97
 - (3) static water level (feet) 47 below top of ground.
 - (4) casing plastic, 92
(material) (depth)
 if telescope see back.
(size)
 - (5) screen 5, 92
(length) (depth to top)
2 in plastic
(size) (material)
 - (6) pump 3/4, 8
(HP) (yield gpm)
Rea
(type power)
 - (7) electric log no
(yes or no)
 - (organization running log)
 - (8) how well bottom plugged wash hole

CODED

DRILLERS REMARKS:

If well telescopes please sketch and show depths.

GROUND LEVEL

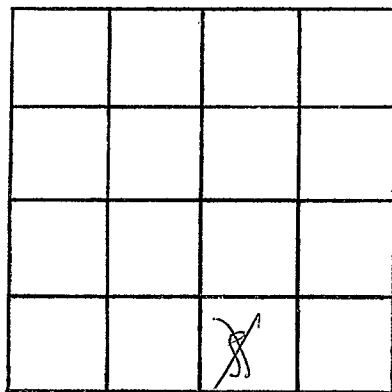

SECTION 2

Please indicate well location X.

ADDITIONAL INFORMATION

If more than one screen,
show locations of each on sketch.