

TMA CA

Wayne  
M 102  
1-27-72

MISSISSIPPI  
BOARD OF WATER COMMISSIONERS  
416 North State Street  
Jackson, Mississippi 39201  
APR 17 1972

CODED

WATER WELL DRILLERS LOG

Don 29 1972 Key U West water Wayne  
date well completed firm name county well located

LANDOWNER: James J Bayles  
Rt 1 Waynesboro  
(mailing address)

description of formations encountered	from	to
hardy clay	0	8
pond	8	40
hardy clay	40	85
lime pond	85	125
hardy clay	125	140
pond	140	163

WELL LOCATION:  
sec. 3 T 8 N R 8 E  
16 miles  $\frac{1}{2}$  of Laurel  
(distance) (direction) (nearest town)

WELL PURPOSE: home  
(home, irrigation, municipal, industrial)


- WELL COMPLETION DATA:
- (1) diameter (inches) 2 in
  - (2) total depth (feet) 163
  - (3) static water level (feet) 48 below top of ground.
  - (4) casing plaster 158  
(material) (depth)  
(size) If telescope see back.
  - (5) screen 5 158  
(length) (depth to top)  
1 1/4 steel  
(size) (material)
  - (6) pump 1 hp 8  
(HP) (yield gpm)  
Rea  
(type power)
  - (7) electric log NO  
(yes or no)
  - (organization running log)
  - (8) how well bottom plugged *was plugged*

CODED

DRILLERS REMARKS:

If well telescopes please sketch and show depths.

GROUND LEVEL

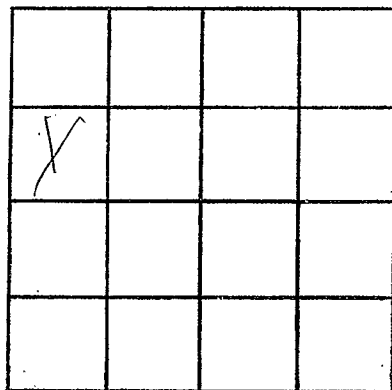

SECTION W

Please indicate well location X.

ADDITIONAL INFORMATION

If more than one screen,  
show locations of each on sketch.