

Wayne
M103
4-5-72

MISSISSIPPI
BOARD OF WATER COMMISSIONERS
416 North State Street
Jackson, Mississippi 39201

CODED

WATER WELL DRILLERS LOG

April 5 1972 Royal West Water Wells Wayne
date well completed firm name county well located

LANDOWNER: Leonard Lee
1671 Woyne Drive
(mailing address)

description of formations encountered	from	to
Clay	0	5
Sand	5	21
Clay	21	45
Sand	45	60
Clay	60	85
Sand	85	131

WELL LOCATION:
sec. 15 T. 8 N. R. 8 E
1.8 miles S.E. of Laurel
(distance) (direction) (nearest town)

WELL PURPOSE: home
(home, irrigation, municipal, industrial)

- WELL COMPLETION DATA:
- (1) diameter (inches) 2 in
 - (2) total depth (feet) 131
 - (3) static water level (feet) 40 below above top of ground.
 - (4) casing galv (material) (depth) (size) if telescope see back.
 - (5) screen 5 (length) 126 (depth to top) 1 1/4 (size) St. Steel (material)
 - (6) pump 1/2 (HP) 18 (yield gpm) PEA (type power)
 - (7) electric log 70 (yes or no)
 - (8) how well bottom plugged Washuoku (organization running log)

CODED


MAY 2 - 1972

MISS. BD. OF WATER COMMISSIONERS

DRILLERS REMARKS:

If well telescopes please sketch and show depths.

GROUND LEVEL

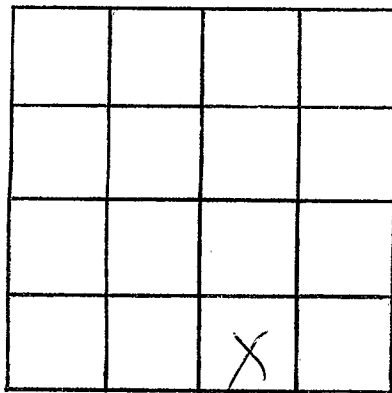

SECTION 15

Please indicate well location X.

ADDITIONAL INFORMATION

If more than one screen,
show locations of each on sketch.