

CODED

WAYNE
M 105
6-15-72

MISSISSIPPI BOARD OF WATER COMMISSIONERS
416 North State Street
Jackson, Mississippi 39201
C. P. CLARK
WATER WELL DRILLING
ROUTE 2
LAUREL, MISS. 39440

WATER WELL DRILLERS LOG

6/15 1972 date well completed
C. P. Clark firm name
Wayne county well located

LANDOWNER: Griffin Carter
Clara Miss

| description of formations encountered | from | to |
|---------------------------------------|------|-----|
| Red clay | 0 | 11 |
| Sand | 11 | 16 |
| Clay | 16 | 60 |
| Sand | 60 | 110 |

(mailing address)

WELL LOCATION:
sec. 31 T. 8 N. R. 8 E
3 miles East of Dugford
(distance) (direction) (nearest town)

WELL PURPOSE: Home
(home, irrigation, municipal, industrial)

- WELL COMPLETION DATA:
- (1) diameter (inches) 2
 - (2) total depth (feet) 110
 - (3) static water level (feet) 45 below top of ground.
 - (4) casing Galvalume (material) (depth)
 - 2 (size) if telescope see back.
 - (5) screen 5 (length) 105 (depth to top)
1/4 (size) 00 S.S (material)
 - (6) pump 3/4 (HP) 12 (yield gpm)
220 (type power)
 - (7) electric log NO (yes or no)
 - (organization running log)
 - (8) how well bottom plugged BWD

CODED


C. P. CLARK
WATER WELL DRILLING
ROUTE 2
LAUREL, MISS. 39440

JUN 22 1972

DRILLERS REMARKS:

If well telescopes please sketch and show depths.

GROUND LEVEL

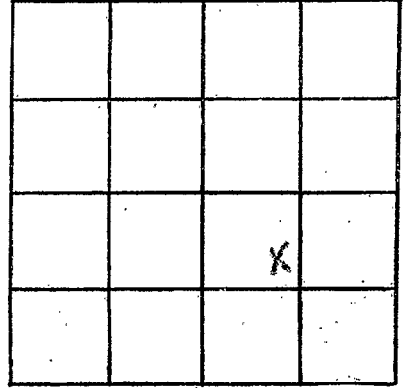

SECTION 31

Please indicate well location X.

ADDITIONAL INFORMATION

If more than one screen, show locations of each on sketch.