

Wayne  
M 108  
9-16-72

MISSISSIPPI  
BOARD OF WATER COMMISSIONERS  
416 North State Street  
Jackson, Mississippi 39201

WATER WELL DRILLERS LOG

**CODED**

SEP 16 1972 Mr. I. L. Wain WATER WELL SER. WAYNE  
date well completed firm name county well located

LANDOWNER:	description of formations encountered	from	to
Dale Pippin Rt 1 Wboro (mailing address)			
WELL LOCATION:	sand + sand rock	9	12
sec. 18 T. 8 N R. 8 E S. 8 W 11 miles W Wboro (distance) (direction) (nearest town)	Clay	12	74
WELL PURPOSE: HOME (home, irrigation, municipal, industrial)	Sand	74	76
WELL COMPLETION DATA:	Clay	76	90
(1) diameter (inches) 2"	fine sand + clay streaks	90	100
(2) total depth (feet) 120'	Clay	100	108
(3) static water level (feet) 53' below top of ground.	Sand	108	120
(4) casing PVC 115' (material) (depth) 2" (size) if telescope see back.			
(5) screen 5' 115' (length) (depth to top) 2" PVC .008 (size) (material)			
(6) pump 1 6 (HP) (yield gpm) 110 AC (type power)			
(7) electric log no (yes or no)  (organization running log)			
(8) how well bottom plugged			
DRILLERS REMARKS:			


**CODED**

SEP 22 1972

MISS. Bd. of  
WATER COMMISSIONERS

If well telescopes please sketch and show depths.

GROUND LEVEL

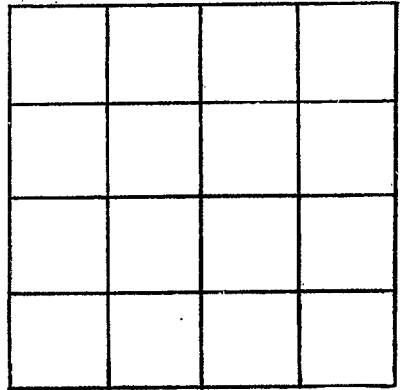

SECTION \_\_\_\_\_

Please indicate well location X.

ADDITIONAL INFORMATION

If more than one screen, show locations of each on sketch.