

MISSISSIPPI  
BOARD OF WATER COMMISSIONERS  
416 North State Street  
Jackson, Mississippi 39201

**CODED**

Wayne  
M 109  
9-18-72

WATER WELL DRILLERS LOG

SEPT 18 1972 McILWAIN WATER WELL SER. Wayne  
date well completed firm name county well located

LANDOWNER:	description of formations encountered	from	to
<u>GRADY H. BEARD</u> <u>RT 1, WAYNESBORO, MISS</u> (mailing address)			
	<u>Sand</u>	<u>18</u>	<u>25</u>
	<u>Clay</u>	<u>25</u>	<u>—</u>
<p>WELL LOCATION:</p> <p>sec. <u>27</u> T. <u>8</u> N R. <u>8</u> E <u>10</u> miles <u>SW</u> of <u>WAYNESBORO</u> (distance) (direction) (nearest town)</p>			
<p>WELL PURPOSE: <u>HOME</u> (home, irrigation, municipal, industrial)</p>			
<p>WELL COMPLETION DATA:</p> <p>(1) diameter (inches) <u>2"</u></p> <p>(2) total depth (feet) <u>25'</u></p> <p>(3) static water level (feet) <u>18'</u> below top of ground.</p> <p>(4) casing <u>PVC</u> <u>20'</u> (material) (depth) <u>2"</u> (size) if telescope see back.</p> <p>(5) screen <u>5'</u> <u>20'</u> (length) (depth to top) <u>2"</u> <u>PVC .008</u> (size) (material)</p> <p>(6) pump <u>1/2</u> <u>5</u> (HP) (yield gpm) <u>110 AC</u> (type power)</p> <p>(7) electric log <u>NO</u> (yes or no)  (organization running log)</p> <p>(8) how well bottom plugged</p>			
DRILLERS REMARKS:			


**CODED**

SEP 22 1972

MISS. DEPT. OF  
AGRICULTURE

If well telescopes please sketch and show depths.

GROUND LEVEL

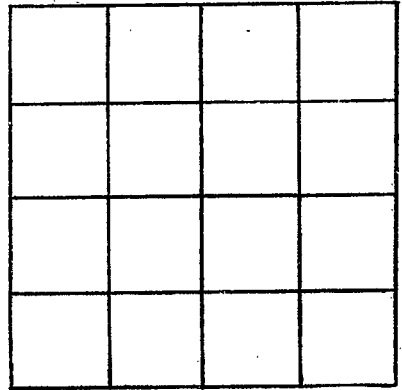

SECTION \_\_\_\_\_

Please indicate well location X.

ADDITIONAL INFORMATION

If more than one screen, show locations of each on sketch.