

WAYNE

M 110

9-13-72

MISSISSIPPI BOARD OF WATER COMMISSIONERS 416 North State Street Jackson, Mississippi 39201

CODED

WATER WELL DRILLERS LOG

Sept 13 1972 Ray W. W. ... Wayne

LANDOWNER: Howard Lewis

Rt 1 Wayneboro Box 1488

(mailing address)

description of formations encountered

from to

clay	0	5
sand	5	20
clay	20	60
sand	60	87

WELL LOCATION:

sec. 5 T. 8 N. R. 8 E 17 miles E of Laurel

WELL PURPOSE: home (home, irrigation, municipal, industrial)

WELL COMPLETION DATA:

- (1) diameter (inches) 2 in
- (2) total depth (feet) 87
- (3) static water level (feet) 65 below top of ground
- (4) casing galv 82 (material) (depth)
- (5) screen 5/8 82 (length) (depth to top)
- (6) pump 1/2 (HP) 6 (yield gpm)
- (7) electric log No (yes or no)

CODED


(organization running log) how well bottom plugged washed

DRILLERS REMARKS:

OCT 12 1972

If well telescopes please sketch and show depths.

GROUND LEVEL

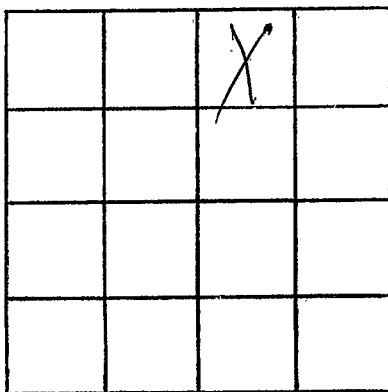

SECTION 5

Please indicate well location X.

ADDITIONAL INFORMATION

If more than one screen, show locations of each on sketch.