

WAYNE  
MILL  
9-24-72

MISSISSIPPI  
BOARD OF WATER COMMISSIONERS  
416 North State Street  
Jackson, Mississippi 39201

**CODED**

WATER WELL DRILLERS LOG

Sept 24 1972 Roy Westcott & Sons Wayne  
date well completed firm name county well located

| LANDOWNER   | description of formations encountered | from | to |
|---|---------------------------------------|------|----|
|   |                                       |      |    |
| Rt 1 - Box 70 waynesboro                              | clay                                  | 0    | 12 |
|   | sandy clay                            | 12   | 30 |
|   | sand                                  | 30   | 75 |
| (mailing address)                                     |                                       |      |    |
| WELL LOCATION:  |                                       |      |    |
| sec. 14 T. 8 <sup>N</sup> S. R. 8 E. W.               |                                       |      |    |
| 12 miles W of waynesboro                              |                                       |      |    |
| (distance) (direction) (nearest town)                 |                                       |      |    |
| WELL PURPOSE: home                                    |                                       |      |    |
| (home, irrigation, municipal, industrial)             |                                       |      |    |
| WELL COMPLETION DATA:                                 |                                       |      |    |
| (1) diameter (inches) 4 in                            |                                       |      |    |
| (2) total depth (feet) 75                             |                                       |      |    |
| (3) static water level (feet) 28 below top of ground. |                                       |      |    |
| (4) casing plastic 70                                 |                                       |      |    |
| (material) (depth)                                    |                                       |      |    |
| (size) If telescope see back.                         |                                       |      |    |
| (5) screen 5 ft 20                                    |                                       |      |    |
| (length) (depth to top)                               |                                       |      |    |
| 2 in St Steel   |                                       |      |    |
| (size) (material)                                     |                                       |      |    |
| (6) pump 1 14   |                                       |      |    |
| (HP) (yield gpm)                                      |                                       |      |    |
| PEA   |                                       |      |    |
| (type power)  |                                       |      |    |
| (7) electric log NO                                   |                                       |      |    |
| (yes or no)   |                                       |      |    |
| (organization running log)                            |                                       |      |    |
| (8) how well bottom plugged wash water                |                                       |      |    |
| DRILLERS REMARKS:                                     |                                       |      |    |


**CODED**

OCT 12 1972

MISS. GE. &  
ENGINEER

If well telescopes please sketch and show depths.

GROUND LEVEL

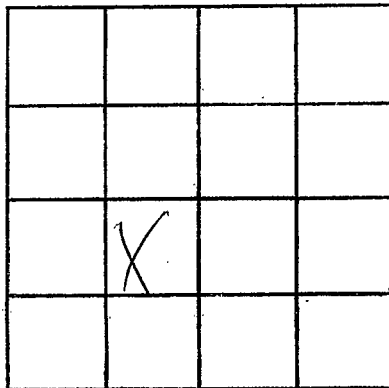

SECTION 14

Please indicate well location X.

ADDITIONAL INFORMATION

If more than one screen,  
show locations of each on sketch.