

**WAYNE**  
**M 114**  
**3-8-74**

MISSISSIPPI  
 BOARD OF WATER COMMISSIONERS  
 416 North State Street  
 Jackson, Mississippi 39201

**CODED**

**WATER WELL DRILLERS LOG**

**McILWAIN WATER WELL SERVICE**

**WAYNE**

**MARCH 8, 74**  
 date well completed

RT. 2 BOX 37  
 firm name  
**WAYNESBORO, MISS. 39367**


county well located

LANDOWNER:	description of formations encountered	from	to
<b>DELFO EZELL</b>	<b>RED CLAY</b>	<b>0</b>	<b>8</b>
<b>WAYNESBORO, MISS.</b> (mailing address)	<b>PINK CLAY</b>	<b>8</b>	<b>18</b>
<b>WELL LOCATION:</b>	<b>FINE SAND</b>	<b>18</b>	<b>25</b>
sec. <b>1</b> T. <b>8</b> N R. <b>8</b> W <b>7</b> miles <b>W</b> of <b>W'BOAR</b> (distance) (direction) (nearest town)	<b>PURPLE CLAY</b>	<b>25</b>	<b>35</b>
<b>WELL PURPOSE:</b> <b>HOME</b> (home, irrigation, municipal, industrial)	<b>PINK GRADED SAND</b>	<b>35</b>	<b>40</b>
<b>WELL COMPLETION DATA:</b>	<b>SAND</b>	<b>40</b>	<b>43</b>
(1) diameter (inches) <b>2"</b>	<b>GRAVEL &amp; COARSE SAND</b>	<b>43</b>	<b>55</b>
(2) total depth (feet) <b>120'</b>	<b>CLAY</b>	<b>55</b>	<b>65</b>
(3) static water level (feet) <b>72'</b> below top of ground.	<b>GRAVEL &amp; SAND</b>	<b>65</b>	<b>75</b>
(4) casing <b>PVC</b> , <b>110'</b> (material) (depth) <b>2"</b> if telescope see back. (size)	<b>CLAY</b>	<b>75</b>	<b>80</b>
(5) screen <b>10'</b> , <b>110'</b> (length) (depth to top) <b>2"</b> , <b>PVC .008</b> (size) (material)	<b>SAND &amp; CLAY</b>	<b>80</b>	<b>85</b>
(6) pump <b>1</b> , <b>7</b> (HP) (yield gpm) <b>220 AC</b> (type power)	<b>COARSE SAND, SOME GRAVEL</b>	<b>85</b>	<b>100</b>
(7) electric log <b>NO</b> (yes or no)	<b>MED SAND</b>	<b>100</b>	<b>120</b>
(organization running log)			
(8) how well bottom plugged			
<b>DRILLERS REMARKS:</b>			

**APR - 4 1974**

If well telescopes please sketch and show depths.

GROUND LEVEL

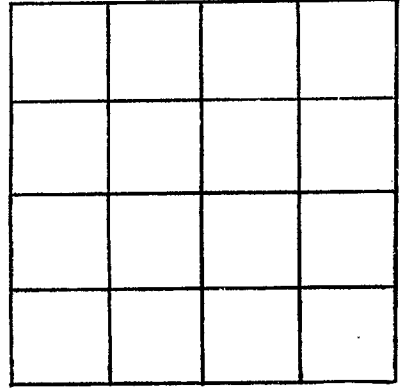

SECTION \_\_\_\_\_

Please indicate well location X.

ADDITIONAL INFORMATION

If more than one screen, show locations of each on sketch.