

MISSISSIPPI
BOARD OF WATER COMMISSIONERS
416 North State Street
Jackson, Mississippi 39201

WATER WELL DRILLERS LOG

CODED

WAYNE

M 116

7-27-74

July 27 1974

Boutin Drilling

Wayne

date well completed

firm name

county well located

LANDOWNER:

Ch. Shaw
24 Williams

description of formations encountered

from

to

At 12 Wagnersboro

(mailing address)

sand & chalk
chalk
med fine sand
with contents of chalk
stopped on chalk

0 65
65 90

WELL LOCATION:

sec. 6 T 20 N R 8 E S 10 W
(distance) (direction) (nearest town)
10 miles W of Wagnersboro

WELL PURPOSE: none
(home, irrigation, municipal, industrial)

WELL COMPLETION DATA:


- (1) diameter (inches) 2"
- (2) total depth (feet) 102'
- (3) static water level (feet) 52' below top of ground.
- (4) casing PVC 94' (material) (depth)
2' if telescope see back. (size)
- (5) screen 8' 94' (length) (depth to top)
1 1/4" ball SS. (size) (material)
- (6) pump 1 (HP) 6 (yield gpm)
elec. (type power)
- (7) electric log no (yes or no)

2' 1/4" ball SS screen
on end of casing
with back wash valve
on end to shell top
above.

62' 1" PVC drop
pipe

(organization running log)

(8) how well bottom plugged
back wash valve

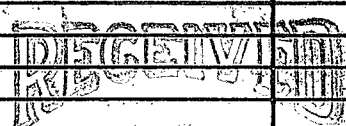

SEP 11 1974

DRILLERS REMARKS:

If well telescopes please
sketch and show depths.

GROUND LEVEL

			X

SECTION 6

Please indicate well location X.

ADDITIONAL INFORMATION

If more than one screen,
show locations of each on sketch.