

MISSISSIPPI
BOARD OF WATER COMMISSIONERS

416 North State Street
Jackson, Mississippi 39201

WATER WELL DRILLERS LOG

CODED

WAYNE

M 117

8-8-74

Aug 8 1974 date well completed
Burt D. Williams firm name
Wayne county well located

LANDOWNER: Stevley
Stevens

description of formations encountered from to

at 5 Waynesboro
(mailing address)

Chalk & Chalk	0	32
Chalk & sand	33	43
Chalk	43	56
Clay & sand	56	69
Clay & sand	69	86
stet. sand		

WELL LOCATION:
sec. 32 T 8 N R. 8 E
7 miles W of Warren
(distance) (direction) (nearest town)

WELL PURPOSE: home
(home, irrigation, municipal, industrial)

WELL COMPLETION DATA:

- (1) diameter (inches) 2"
- (2) total depth (feet) 86'
- (3) static water level (feet) 52' (below/above top of ground)
- (4) casing PVC 82'
(material) (depth)
2" if telescope see back.
(size)
- (5) screen 4" 82'
(length) (depth to top)
1 1/4" stet. S.S.
(size) (material)
- (6) pump 1 1/2 12
(HP) (yield gpm)
elec.
(type power)
- (7) electric log no
(yes or no)

4' stet. S.S.
screened on end of casing
with back wash hole
on end to shed large
above
62' 1" P.V.C. drop
pipe

(organization running log)

(8) how well bottom plugged
back wash hole


DRILLERS REMARKS:

RECEIVED
SEP 11 1974

MISS. Bd. OF WATER COMM.

If well telescopes please sketch and show depths.

GROUND LEVEL

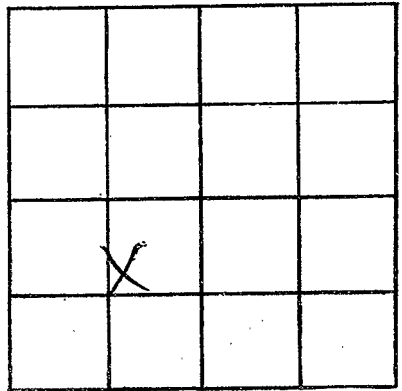

SECTION 32

Please indicate well location X.

ADDITIONAL INFORMATION

If more than one screen,
show locations of each on sketch.