

WAYNE  
M 118  
9-18-74

MISSISSIPPI  
BOARD OF WATER COMMISSIONERS  
416 North State Street  
Jackson, Mississippi 39201

CODED

WATER WELL DRILLERS LOG

Sept 18 1974 date well completed  
24 Porter & Sons, Inc. firm name  
Wayne county well located

LANDOWNER: D. J. McMichael

description of formations encountered

from to

at 5 Bay 494  
Waynesboro Miss  
(mailing address)

well clean sand	0	15
fine to med chert	15	60
coarse sand with chert	60	65
fine to med chert		
sand	65	79

WELL LOCATION:

sec 22 T 8 N R 8 E  
7 miles W of Waynesboro  
(distance) (direction) (nearest town)

WELL PURPOSE: Home  
(home, irrigation, municipal, industrial)

WELL COMPLETION DATA:


- (1) diameter (inches) 2'
- (2) total depth (feet) 79'
- (3) static water level (feet) 45' below top of ground.
- (4) casing PVC 74' (material) (depth)  
2" if telescope see back. (size)
- (5) screen 5' 74' (length) (depth to top)  
1 1/4" Galv. S.S. (size) (material)
- (6) pump 1 HP 10 (HP) (yield gpm)  
elec (type power)
- (7) electric log yes (yes or no)

(organization running log)

(8) how well bottom plugged  
back wash valve

DRILLERS REMARKS:


5 1/4" hole in sand on end of cas with back wash valve on end of 1" diameter above  
CODED  
62' 1" P.V.C. casing pipe

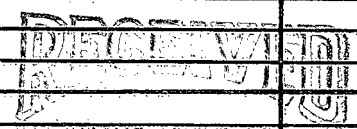

OCT 22 1974

If well telescopes please sketch and show depths.

GROUND LEVEL

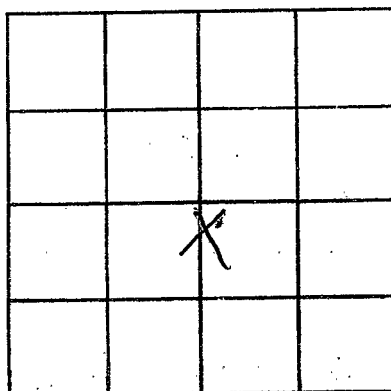

SECTION 22

Please indicate well location X.

ADDITIONAL INFORMATION

If more than one screen, show locations of each on sketch.