

WAYNE
M 119
1-15-75

MISSISSIPPI
BOARD OF WATER COMMISSIONERS
416 North State Street
Jackson, Mississippi 39201

WATER WELL DRILLERS LOG
McILWAIN WATER WELL SERVICE

CODED

Wayne

Jan 15 1975
date well completed


RT. 2 BOX 37
firm name
WAYNESBORO, MISS. 39367

county well located

LANDOWNER:	description of formations encountered	from	to
Woodrow Dykes	Red Clay	0	10
Waynesboro, Miss. (mailing address)	Clay	10	22
	Coarse Sand + gravel	22	29
WELL LOCATION:			
sec. <u>1</u> T. <u>8</u> N R. <u>3</u> W			
<u>7</u> miles <u>W</u> of <u>W'BORO</u> (distance) (direction) (nearest town)			
WELL PURPOSE: <u>Home</u> (home, irrigation, municipal, industrial)			
WELL COMPLETION DATA:			
(1) diameter (inches) <u>2"</u>			
(2) total depth (feet) <u>29'</u>			
(3) static water level (feet) <u>22'</u> above below top of ground.			
(4) casing <u>PVC</u> <u>24'</u> (material) (depth)			
<u>2"</u> (size) if telescope see back.			
(5) screen <u>5'</u> <u>24'</u> (length) (depth to top)			
<u>2"</u> <u>PVC #008</u> (size) (material)			
(6) pump <u>1</u> <u>11</u> (HP) (yield gpm)			
<u>110 AC</u> (type power)			
(7) electric log <u>no</u> (yes or no)			
(organization running log)			
(8) how well bottom plugged			
DRILLERS REMARKS:			
FEB 1 1975 FEB 1 1975			
MISS. Bd. OF WATER COMM.			

If well telescopes please sketch and show depths.

GROUND LEVEL

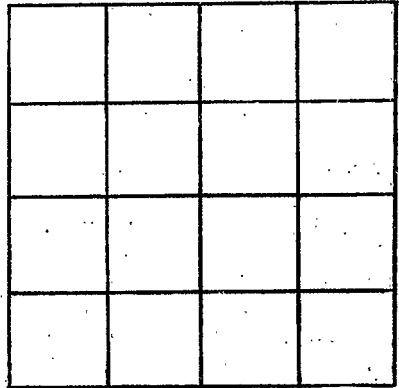

SECTION _____

Please indicate well location X.

ADDITIONAL INFORMATION

If more than one screen, show locations of each on sketch.