

WAYNE  
M121  
9-3-78

MISSISSIPPI  
BOARD OF WATER COMMISSIONERS  
416 North State Street  
Jackson, Mississippi 39201

CODED

WATER WELL DRILLERS LOG

Sept 3 1978 Griner Drilling Wayne  
date well completed firm name county well located

LANDOWNER:  
Columbia Gas  
P.O. Box 1350  
Houston, Texas 77001  
(mailing address)

description of formations encountered	from	to
0-21 sand	0	21
clay	21	105
sand & gravel	105	147
chalk & rock	147	294
sand	294	315
chalk, rock streaked sand	315	378

WELL LOCATION:  
sec. 12 T. 8 N R. 8 E  
S W  
6 miles west of Weynesboro  
(distance) (direction) (nearest town)

WELL PURPOSE: oil field supply  
(home, irrigation, municipal, industrial)

- WELL COMPLETION DATA:
- (1) diameter (inches) 3"
  - (2) total depth (feet) 378'
  - (3) static water level (feet) 105' <sup>below</sup> top of ground.
  - (4) casing steel 357'  
(material) (depth)  
3" (size) If telescope see back.
  - (5) screen 42' 315'  
(length) (depth to top)  
3" perforated  
(size) (material)
  - (6) pump 40  
(HP) (yield gpm)  
AC  
(type power)
  - (7) electric log \_\_\_\_\_  
(yes or no)  
(organization running log)
  - (8) how well bottom plugged orange  
peel


DRILLERS REMARKS:

DRILLER'S SIGNATURE  
SEP - 7 1978

MISS. Bd. OF WATER COMM.

If well telescopes please sketch and show depths.

GROUND LEVEL

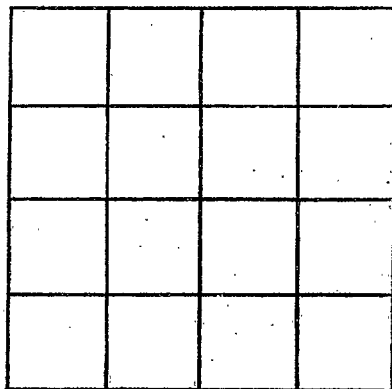

SECTION \_\_\_\_\_

Please indicate well location X.

ADDITIONAL INFORMATION

If more than one screen, show locations of each on sketch.