

M122
 WAYNE CO
 4-13-84

MISSISSIPPI
 BOARD OF WATER COMMISSIONERS
 416 North State Street
 Jackson, Mississippi 39201

CODED

WATER WELL DRILLERS LOG

4-13 1984 Roy U. WEST Drlg WAYNE
 date well completed firm name county well located

LANDOWNER:	description of formations encountered	from	to
DEWEY MCKEE			
WAYNES BORO MS (mailing address)	SAND	12	32
	CLAY	32	86
	SAND	86	120

WELL LOCATION:
 sec. 10 T 8 N R 8 E
 S W
 8 miles W of WAYNES BORO
 (distance) (direction) (nearest town)

CODED

WELL PURPOSE:
 (home, irrigation, municipal, industrial)

WELL COMPLETION DATA:

(1) diameter (inches) 4"

(2) total depth (feet) 120'

(3) static water level (feet) 75' below top of ground.

(4) casing PUC 110'
 (material) (depth)
 4" (size) if telescope see back.

(5) screen 10' 110'
 (length) (depth to top)
 4" (size) PUC (material)

(6) pump 1 20
 (HP) (yield gpm)
 REA (type power)

(7) electric log NO
 (yes or no)

(organization running log)

(8) how well bottom plugged
 WASH VALVE

DRILLERS REMARKS:


SECT. OF NATURAL RESOURCES
 BUREAU OF LAND & WATER RESOURCES

APR 10 1984

RECEIVED

If well telescopes please sketch and show depths.

GROUND LEVEL

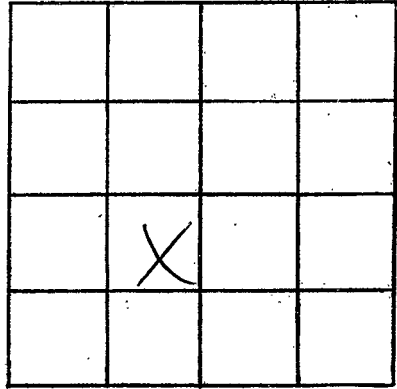

SECTION 10

Please indicate well location X.

ADDITIONAL INFORMATION

If more than one screen, show locations of each on sketch.