

MISSISSIPPI DEPARTMENT OF NATURAL RESOURCES

Bureau of Land and Water Resources

Southport Mall

P.O. Box 10631

Jackson, Mississippi 39209 CODED

WATER WELL DRILLERS LOG

M 123  
Wayne.  
11-1-84

10-11 1984 Roy L. West Dalg WAYNE  
date well completed firm name county well located

LANDOWNER:  
Dobbins Drilling  
Quiltman MS  
(mailing address)

description of formations encountered	from	to
CLAY	0	3
SAND	3	25
CLAY	25	175
SAND	175	210

WELL LOCATION:  
sec. 9 T. 8 N. R. 8 E  
S W  
10 miles W of WAYNE DORO  
(distance) (direction) (nearest town)

Coho Res. Inc. #1  
SCOTT G. WEST 9-6  
1650'S + 2291'E  
Q of NW Cor

WELL PURPOSE: FRESH WATER  
(home, irrigation, municipal, industrial)

WELL COMPLETION DATA:

- (1) diameter (inches) 4"
- (2) total depth (feet) 210'
- (3) static water level (feet) 65' below top of ground.
- (4) casing PVC, 190'  
(material) (depth)
- (size) If telescope see back.
- (5) screen 20', 190'  
(length) (depth to top)
- 4" PVC  
(size) (material)
- (6) pump AIR 80  
(HP) (yield gpm)
- f  
(type power)
- (7) electric log NO  
(yes or no)
- (organization running log)
- (8) how well bottom plugged  
CONSH VALVE

DRILLERS REMARKS:


DEPT. OF NATURAL RESOURCES  
BUREAU OF LAND & WATER RESOURCES

DEC - 5 1984

RECEIVED

If well telescopes please sketch and show depths.

GROUND LEVEL

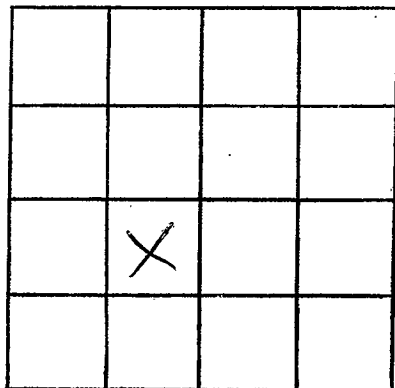

SECTION 9

Please indicate well location X.

ADDITIONAL INFORMATION

If more than one screen, show locations of each on sketch.