

MISSISSIPPI DEPARTMENT OF NATURAL RESOURCES

Bureau of Land and Water Resources

Southport Mall

P.O. Box 10631

Jackson, Mississippi 39209

WATER WELL DRILLERS LOG

M 124
Wayne

March 26 1985 Porter Drilling & Log Wayne
 date well completed firm name county well located

LANDOWNER:	description of formations encountered	from	to
Joe Mc Michael Rt 5 Waynesboro	fine to med sand distilling sand when started drilling	0	82
(mailing address)			
WELL LOCATION:			
sec 22 T 8 N R 8 E 8 miles W Waynesboro			
(distance) (direction) (nearest town)	42' 1" PVC dog pipe		
WELL PURPOSE: Cattle			
(home, irrigation, municipal, industrial)			
WELL COMPLETION DATA:			
(1) diameter (inches) 2"			
(2) total depth (feet) 82'			
(3) static water level (feet) 31' (below above top of ground)			
(4) casing PVC 77' (material) (depth)			
2' (size) if telescope see back.			
(5) screen 5' 77' (length) (depth to top)			
2" (size) belt S.S. (material)			
(6) pump 1 12 (HP) (yield gpm)			
elec. (type power)			
(7) electric log no (yes or no)			
(organization running log)			
(8) how well bottom plugged 2' sand shock			

RECEIVED


MAY - 6 1985

DRILLERS REMARKS:

Department of Natural Resources
 Bureau of Land & Water Resources

If well telescopes please sketch and show depths.

GROUND LEVEL

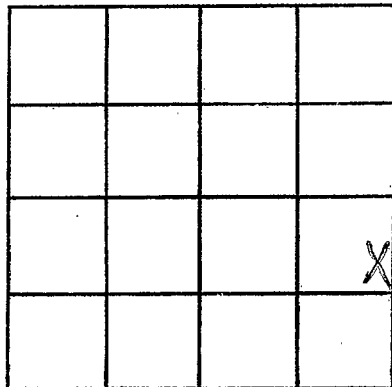

SECTION 22

Please indicate well location X.

ADDITIONAL INFORMATION

If more than one screen,
show locations of each on sketch.