

MISSISSIPPI DEPARTMENT OF NATURAL RESOURCES

Bureau of Land and Water Resources

Southport Mall

P.O. Box 10631

Jackson, Mississippi 39209

WATER WELL DRILLERS LOG


CODED

WAYNE
M 125

3-10-79 86 Tom Griffith Well Service WAYNE
date well completed firm name county well located

LANDOWNER: <u>Grace France</u> <u>300 Marshall St,</u> <u>Shreveport, La 71101</u> (mailing address)	description of formations encountered	from	to
WELL LOCATION: 18 T 8 N S R 8 W <u>4</u> miles <u>E</u> of <u>Waynesboro</u> (distance) (direction) (nearest town)			
WELL PURPOSE: <u>OIL LOCATION</u> (home, irrigation, municipal, industrial)	#1 SCOTT PAPER		
WELL COMPLETION DATA: (1) diameter (inches) <u>4"</u> (2) total depth (feet) <u>200'</u> (3) static water level (feet) <u>15</u> ^{below} above top of ground. (4) casing <u>PVC</u> <u>180'</u> (material) (depth) _____ if telescope see back. (size) (5) screen <u>20'</u> <u>180'</u> (length) (depth to top) <u>4"</u> <u>PVC</u> (size) (material) (6) pump <u>5 hp</u> <u>70 GPM</u> (HP) (yield gpm) <u>ELECTRIC</u> (type power) (7) electric log <u>No</u> (yes or no) <u>N/A</u> (organization running log) (8) how well bottom plugged <u>BWV</u>			
DRILLERS REMARKS:			

CODED

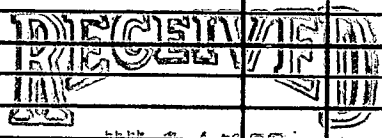

JUL 14 1985

Department of Natural Resources
Bureau of Land & Water Resources

