

MISSISSIPPI DEPARTMENT OF NATURAL RESOURCES

Bureau of Land and Water Resources

Southport Mall

P.O. Box 10631

Jackson, Mississippi 39209

CODED

WATER WELL DRILLERS LOG

Griner Drilling Service, Inc.

Wayne

Wayne  
M 126

4-16-87 date well completed

Griner Drilling Service, Inc. firm name

Wayne county well located

LANDOWNER:	description of formations encountered	from	to
Chesley Pruet Drilling P.O. Box 324 Laurel, Ms. 39440 (mailing address)	sand, gravel	0	248
WELL LOCATION: 1800'S & 200'W	rock, clay	248	252
sec. 10 T 8 N R 8 E of Pruet production Beat 4 (distance) School (nearest town) No. 10-1			
WELL PURPOSE: oilfield rig (home, irrigation, municipal, industrial) supply			
WELL COMPLETION DATA:			
(1) diameter (inches) 4"			
(2) total depth (feet) 252'			
(3) static water level (feet) 90' below top of ground.			
(4) casing steel 252' (material) (depth) 4" (size) if telescope see back.			
(5) screen 42', 210' (length) (depth to top) 4" perforated (size) (material)			
(6) pump AC (HP) 75 (yield gpm) (type power)			
(7) electric log (yes or no) (organization running log)			
(8) how well bottom plugged orange peel			
DRILLERS REMARKS:			

CODED


RECEIVED

MAY 13 1987

Department of Natural Resources  
Bureau of Land & Water Resources

If well telescopes please sketch and show depths.

GROUND LEVEL

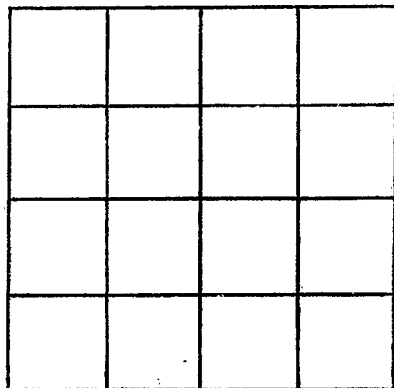

SECTION \_\_\_\_\_

Please indicate well location X.

ADDITIONAL INFORMATION

If more than one screen, show locations of each on sketch.