

Wayne
M 127
294B

**MISSISSIPPI
 BOARD OF WATER COMMISSIONERS**
 416 North State Street
 Jackson, Mississippi 39201

WATER WELL DRILLERS LOG

Oct 9 1987 W. J. Drilling Co. Inc. Wayne
 date well completed firm name county well located

LANDOWNER: James McMichael
Route 5, Box 526
Waynesboro, Mo
 (mailing address)

WELL LOCATION:
 sec. 27 T. 8 N R. 8 E
9 miles N of Clare
 (distance) (direction) (nearest town)

WELL PURPOSE: Home
 (home, irrigation, municipal, industrial)

- WELL COMPLETION DATA:
- (1) diameter (inches) 4
 - (2) total depth (feet) 140
 - (3) static water level (feet) 44 below above top of ground.
 - (4) casing PVC, 134'
 (material) (depth)
 (size) if telescope see back.
 - (5) screen 10, 134'
 (length) (depth to top)
4", PVC
 (size) (material)
 - (6) pump 1 32
 (HP) (yield gpm)
220V
 (type power)
 - (7) electric log no
 (yes or no)
 (organization running log)
 - (8) how well bottom plugged good

description of formations encountered	from	to
Top soil	0	1
Hard tan clay	1	10
Sandy clay	10	13
Sand	13	19 1/2
Gravelly sand	19 1/2	20
Tannish yellow clay	20	24
White clay	24	29
Clay with sandy streaks	29	29 1/2
Sand, yellow	65	76
Clay	76	78
Sand, yellow	78	92
Sand, yellow breaks	92	95
Sand	95	102
Clay	102	103
Sand	103	109
Rock	109	109 1/2
Coarse sand	109 1/2	140

RECEIVED


NOV 12 1987

Department of Natural Resources
 Bureau of Land & Water Resources

DRILLERS REMARKS:

If well telescopes please sketch and show depths.

GROUND LEVEL

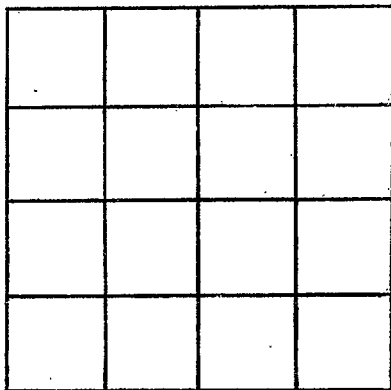

SECTION _____

Please indicate well location X.

ADDITIONAL INFORMATION

If more than one screen, show locations of each on sketch.