

Wayne
 M 2000
 12-10-76

MISSISSIPPI
 BOARD OF WATER COMMISSIONERS
 416 North State Street
 Jackson, Mississippi 39201

WATER WELL DRILLERS LOG

Dec 10 1976 *Porter Drilling Co* Wayne
 date well completed firm name county well located

LANDOWNER: <i>James Mc Michael</i>	description of formations encountered	from	to
		<i>At 52 Magneshboro Miss</i> (mailing address)	<i>red clay</i>
	<i>hard sand</i>	15	21
	<i>clay</i>	21	22

WELL LOCATION:
 sec. 27 T 8 N R 8 E
8 miles SW of Waynesboro
 (distance) (direction) (nearest town)

WELL PURPOSE: drinking
 (home, irrigation, municipal, industrial)

- WELL COMPLETION DATA:
- (1) diameter (inches) 2"
 - (2) total depth (feet) 22
 - (3) static water level (feet) 17 below above top of ground.
 - (4) casing PVC 17
(material) (depth)
2 if telescope see back.
(size)
 - (5) screen 5' 17'
(length) (depth to top)
2" PVC 3/4"
(size) (material)
 - (6) pump 1/2 5
(HP) (yield gpm)
elec
(type power)
 - (7) electric log no
(yes or no)
 - (organization running log)
 - (8) how well bottom plugged fully


DRILLERS REMARKS:

RECEIVED
 FEB - 7 1977

MISS. BD. OF WATER COMM.

If well telescopes please sketch and show depths.

GROUND LEVEL

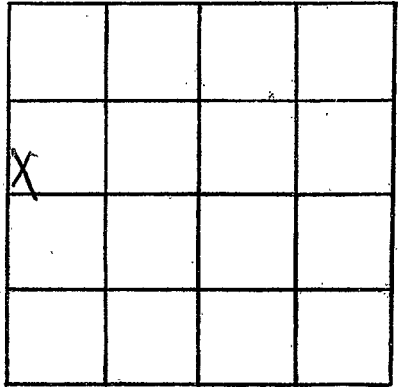

SECTION 27

Please indicate well location X.

ADDITIONAL INFORMATION

If more than one screen, show locations of each on sketch.