

WAYNE
 M 2001
 2-20-76

MISSISSIPPI
 BOARD OF WATER COMMISSIONERS
 416 North State Street
 Jackson, Mississippi 39201

WATER WELL DRILLERS LOG

Feb 20 1976 Bob Drilling & Log Wayne
 date well completed firm name county well located

LANDOWNER: Tomlinson
Homes Dr. Lane Lane
P.O. Box 363 Waynesboro
 (mailing address)

description of formations encountered	from	to
red clay & sand	0	26
clay	26	45
sand	45	60
clay & sand	60	77
sand some gravel	77	105
shaly shell shell		

WELL LOCATION:
 sec 10 T 8 (N) R 8 (E)
7 miles W of Waynesboro
 (distance) (direction) (nearest town)

description of formations encountered	from	to
clay & sand	60	77
sand some gravel	77	105
shaly shell shell		

WELL PURPOSE: home
 (home, irrigation, municipal, industrial)

WELL COMPLETION DATA:
 (1) diameter (inches) 2"
 (2) total depth (feet) 105'
 (3) static water level (feet) 70 (below top of ground)
 (4) casing PVC 100' (material) (depth)
2" (size) if telescope see back.
 (5) screen 5 100' (length) (depth to top)
1/4" (size) brass S.S. (material)
 (6) pump 1/2 12 (HP) (yield gpm)
elec. (type power)
 (7) electric log no (yes or no)
 (organization running log)

5' 1/2" brassy
screw on out of core
with liquid wash
on end of shell
above
82' 1" PVC drive
pipe

(8) how well bottom plugged brass wash valve


DRILLERS REMARKS:

APR 10 1976

MISS. BD. OF WATER

If well telescopes please sketch and show depths.

GROUND LEVEL

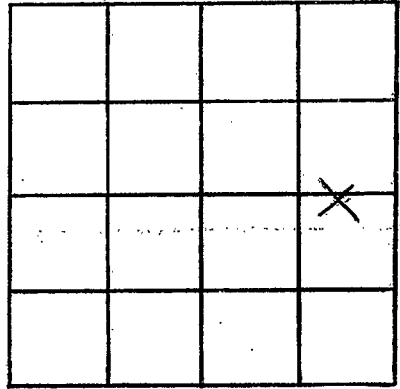

SECTION 10

Please indicate well location X.

ADDITIONAL INFORMATION

If more than one screen,
show locations of each on sketch.