

WAYNE
 M 2004
 6-14-77

MISSISSIPPI
 BOARD OF WATER COMMISSIONERS
 416 North State Street
 Jackson, Mississippi 39201

WATER WELL DRILLERS LOG
 MCILWAIN WATER WELL SERVICE

June 14 1977 RT. 2, BOX 37
 date well completed WAYNESBORO, MISS. 39302

Wayne
 county well located

LANDOWNER:
 John D. Sanderson
 Waynesboro Miss.
 (mailing address)

description of formations encountered	from	to
Red Clay	0	5
Mixed Clay	5	48
Sand	48	57
Clay	57	59
Sand	59	62
Clay	62	65
Sand	65	71

WELL LOCATION:
 sec. 28 T 8 N R 8 E
 12 miles SW of W'boro
 (distance) (direction) (nearest town)

WELL PURPOSE: home
 (home, irrigation, municipal, industrial)

WELL COMPLETION DATA:
 (1) diameter (inches) 2"
 (2) total depth (feet) 70'
 (3) static water level (feet) 58' below top of ground.
 (4) casing PVC 60' (material) (depth)
 2" (size) If telescope see back.
 (5) screen 10' 60' (length) (depth to top)
 2" PVC .008 (size) (material)
 (6) pump 1 9 (HP) (yield gpm)
 220 AC (type power)
 (7) electric log No (yes or no)

(organization running log)
 (8) how well bottom plugged


DRILLERS REMARKS:

RECEIVED
 JUL 22 1977

MISS. BB. OF WATER COMMISSIONERS

If well telescopes please sketch and show depths.

GROUND LEVEL

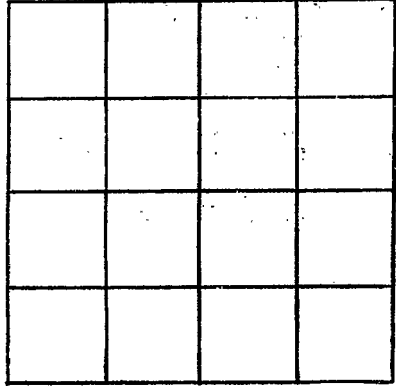

SECTION _____

Please indicate well location X.

ADDITIONAL INFORMATION

A series of horizontal lines providing space for additional information.

If more than one screen, show locations of each on sketch.