

WAYNE  
M 2005  
8-1-77

MISSISSIPPI  
BOARD OF WATER COMMISSIONERS  
416 North State Street  
Jackson, Mississippi 39201

13d out

WATER WELL DRILLERS LOG

MOLWAIN WATER WELL SERVICE


Aug 1 19 77 BY 2 BOX 27 WAYNESBORO, MISS 39267 Wayne county well located

LANDOWNER:	description of formations encountered	from	to
John d. Sanserson Waynesboro Miss (mailing address)	Red Clay	0	10
WELL LOCATION:	Sand + Clay	10	40
sec. 28 T 8 N R 8 W 8 1/2 miles SW of Willow (distance) (direction) (nearest town)	Clay	40	52
WELL PURPOSE: Home (home, irrigation, municipal, industrial)	Sand + Clay	52	72
WELL COMPLETION DATA:	Clay	72	88
(1) diameter (inches) 2"	Fine Sand	88	95
(2) total depth (feet) 135'	Clay	95	112
(3) static water level (feet) 83' below top of ground	Fine Sand	112	120
(4) casing PVC 130' (material) (depth)	Clay Med. Sand	120	135
2" if telescope see back. (size)			
(5) screen 5' 130' (length) (depth to top)			
2" PVC #008 (size) (material)			
(6) pump 1 5 (HP) (yield gpm)			
110 AC (type power)			
(7) electric log No (yes or no)			
(organization running log)			
(8) how well bottom plugged			
DRILLERS REMARKS:			

RECEIVED  
SEP 19 1977

If well telescopes please sketch and show depths.

GROUND LEVEL

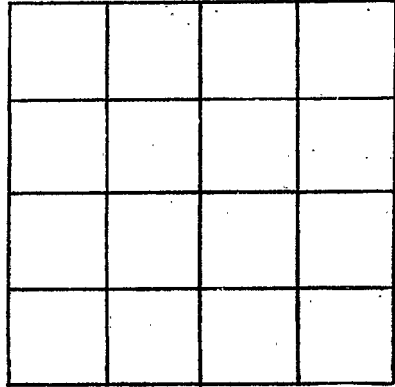

SECTION \_\_\_\_\_

Please indicate well location X.

ADDITIONAL INFORMATION

If more than one screen, show locations of each on sketch.