

WAYNE

M 2007

11/1/77

MISSISSIPPI BOARD OF WATER COMMISSIONERS 416 North State Street Jackson, Mississippi 39201

WATER WELL DRILLERS LOG

Nov 1 1977 date well completed

Boyer Drilling & Pump firm name

Wayne county well located

LANDOWNER: Harvey Miller 215 Boy 502 Wagneshoro Miss (mailing address)

WELL LOCATION: sec 22 T 20 N R 8 E 8 miles west Wagneshoro (distance) (direction) (nearest town)

WELL PURPOSE: Home (home, irrigation, municipal, industrial)

- WELL COMPLETION DATA: (1) diameter (inches) 2" (2) total depth (feet) 95' (3) static water level (feet) 53 below top of ground. (4) casing P.V.C. 90' (material) (depth) (5) screen 5' 90' (length) (depth to top) 2" galv. S.S. (size) (material) (6) pump 1 (HP) 10 (yield gpm) elec. (type power) (7) electric log yes (yes or no) (organization running log) (8) how well bottom plugged 1/4 inch wash on hole

DRILLERS REMARKS:


Table with 3 columns: description of formations encountered, from, to. Contains handwritten entries: 'red clay', 'clay & sand', 'sandstone clay', 'stone on top of clay', '62' 1" P.V.C. clay pipe', '5' 2" galv. S.S. screen with shell trap above to 1/4 inch break stand valve on end'.

RECEIVED JAN 27 1978

MISS. BD. OF WATER COMMISSIONERS

If well telescopes please sketch and show depths.

GROUND LEVEL

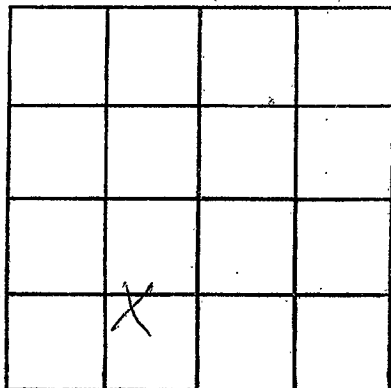

SECTION 22

Please indicate well location X.

ADDITIONAL INFORMATION

If more than one screen,  
show locations of each on sketch.