

WAYNE  
 M 2009  
 1-4-78

MISSISSIPPI  
 BOARD OF WATER COMMISSIONERS  
 416 North State Street  
 Jackson, Mississippi 39201

WATER WELL DRILLERS LOG  
 McILWAIN WATER WELL SERVICE

JAN 4  
 date well completed

1978

RT. 2 BOX 37

firm name

WAYNESBORO, MISS. 39367

WAYNE

county well located

LANDOWNER:	description of fomations encountered	from	to
<i>D Chifton Runnels</i>			
<i>Waynesboro Miss</i> (mailing address)	<i>Sand</i>	<i>6</i>	<i>14</i>
WELL LOCATION:	<i>Clay</i>	<i>14</i>	<i>17</i>
sec. <i>4</i> T. <i>8</i> N R. <i>8</i> W	<i>Sand</i>	<i>17</i>	<i>16</i>
<i>2</i> miles <i>SE</i> of <i>Whistler</i>			
(distance) (direction) (nearest town)			
WELL PURPOSE: <i>HOME</i> (home, irrigation, municipal, industrial)			
WELL COMPLETION DATA:			
(1) diameter (inches) <i>2"</i>			
(2) total depth (feet) <i>64'</i>			
(3) static water level (feet) <i>33'</i> below above top of ground.			
(4) casing <i>PVC</i> <i>59'</i> (material) (depth)			
<i>2"</i> (size) if telescope see back.			
(5) screen <i>5'</i> <i>59'</i> (length) (depth to top)			
<i>2"</i> <i>PVC .008</i> (size) (material)			
(6) pump <i>1/2</i> <i>8 GPM</i> (HP) (yield gpm)			
<i>110 AC</i> (type power)			
(7) electric log <i>NO</i> (yes or no)			
(organization running log)			
(8) how well bottom plugged			


RECEIVED  
 APR 24 1978

DRILLERS REMARKS:

MISS. BD. OF WATER COMMISSIONERS

If well telescopes please sketch and show depths.

GROUND LEVEL

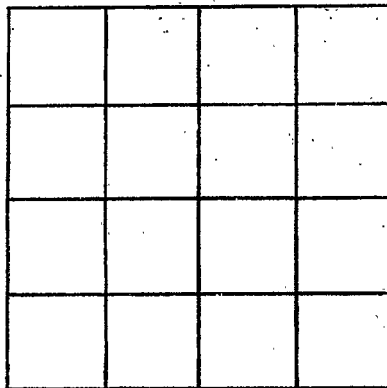

SECTION \_\_\_\_\_

Please indicate well location X.

ADDITIONAL INFORMATION

If more than one screen, show locations of each on sketch.