

WAYNE

M 2011

MISSISSIPPI
 BOARD OF WATER COMMISSIONERS
 416 North State Street
 Jackson, Mississippi 39201

WATER WELL DRILLERS LOG

June 1, 1978 Ray West Water Well Wayne
 date well completed firm name county well located

LANDOWNER: <u>Roger McMichalski</u>	description of formations encountered	from	to
<u>Rt 4</u> <u>Waynesboro</u> (mailing address)			
	<u>clay</u>	<u>0</u>	<u>15</u>
	<u>sandy clay</u>	<u>15</u>	<u>65</u>
	<u>sand</u>	<u>65</u>	<u>110</u>

WELL LOCATION:
 sec. 22 T 8 N R 8 E
 S W
12 miles W of Waynesboro
 (distance) (direction) (nearest town)

WELL PURPOSE: home
 (home, irrigation, municipal, industrial)


- WELL COMPLETION DATA:
- (1) diameter (inches) 2
 - (2) total depth (feet) 110
 - (3) static water level (feet) 45 below above top of ground.
 - (4) casing PVC 105
 (material) (depth)
 (size) if telescope see back.
 - (5) screen 5 105
 (length) (depth to top)
1/4 st steel
 (size) (material)
 - (6) pump 1 8
 (HP) (yield gpm)
Rea
 (type power)
 - (7) electric log no
 (yes or no)
 (organization running log)
 - (8) how well bottom plugged washed

DRILLERS REMARKS:

RECEIVED
 AUG - 2 1978

If well telescopes please sketch and show depths.

GROUND LEVEL

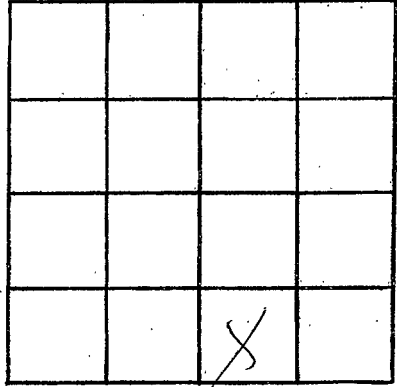

SECTION 22

Please indicate well location X.

ADDITIONAL INFORMATION

If more than one screen, show locations of each on sketch.