

WAYNE
 M 2012
 9-5-78

MISSISSIPPI
 BOARD OF WATER COMMISSIONERS
 416 North State Street
 Jackson, Mississippi 39201

WATER WELL DRILLERS LOG

Sept. 5 1978 Porter Drilling Wayne
 (date well completed) firm name county well located

LANDOWNER: Mrs. Jones
Street
Box 1 Haynesboro Miss
 (mailing address)
 sec. 10 T 8 N R 8 E
7 miles W of Haynesboro
 (distance) (direction) (nearest town)

description of formations encountered	from	to
sand & clay	0	26
clay	26	45
fine red sand	45	52
thin rock		52
blue clay	52	87
red sand & clay	87	97
sand	97	103
clay some sand	103	109
red sand	109	133
closed white		
still in sand		


WELL PURPOSE: domestic
 (home, irrigation, municipal, industrial)

WELL COMPLETION DATA:
 (1) diameter (inches) 2"
 (2) total depth (feet) 133
 (3) static water level (feet) 69 (below/above top of ground)
 (4) casing PVC 129'
 (material) (depth)
2' If telescope see back.
 (size)
 (5) screen 4' 129'
 (length) (depth to top)
1/4" 6 x 6 SS
 (size) (material)
 (6) pump 1 7
 (HP) (yield gpm)
elec
 (type power)
 (7) electric log no
 (yes or no)
 (organization running log)

22' 1" P.V.C. drop
prop
0 0

(8) how well bottom plugged
1/2" track wash valve

DRILLERS REMARKS:

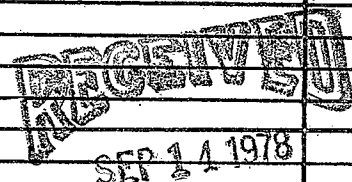

MISS. BD. OF WATER COMM

If well telescopes please sketch and show depths.

GROUND LEVEL

X			

SECTION 10

Please indicate well location X.

ADDITIONAL INFORMATION

If more than one screen,
show locations of each on sketch.