

WAYNE
M 2014
1-31-79

**MISSISSIPPI
BOARD OF WATER COMMISSIONERS**
416 North State Street
Jackson, Mississippi 39201

WATER WELL DRILLERS LOG

Jan 31 1979 Porter Drilling & Log Wayne
 date well completed firm name county well located

LANDOWNER: Dorothy Walker
215 Bay 521
Waynesboro Miss
 (mailing address)

description of formations encountered	from	to
<u>clay & sand</u>	<u>0</u>	<u>36</u>
<u>red soil</u>	<u>36</u>	<u>67</u>
<u>stratified white shell</u>		
<u>and soft sand</u>		
<u>60' 1" P.V.C. log pipe</u>		

WELL LOCATION:
 sec 22 T 8 N 8 E
 S W
7 miles W of Waynesboro
 (distance) (direction) (nearest town)

WELL PURPOSE: Home
 (home, irrigation, municipal, industrial)

- WELL COMPLETION DATA:**
- (1) diameter (inches) 2"
 - (2) total depth (feet) 67'
 - (3) static water level (feet) 38' (below/above top of ground)
 - (4) casing PVC 62'
 (material) (depth)
2" if telescope see back.
 (size)
 - (5) screen 5' 62'
 (length) (depth to top)
2" slot P.V.C.
 (size) (material)
 - (6) pump 1 8
 (HP) (yield gpm)
elec.
 (type power)
 - (7) electric log no
 (yes or no)


(organization running log)
 (8) how well bottom plugged 1 1/2" track wash valve

DRILLERS REMARKS:

Miss. Board of Water Comm.
FEB 6 1979

If well telescopes please sketch and show depths.

GROUND LEVEL

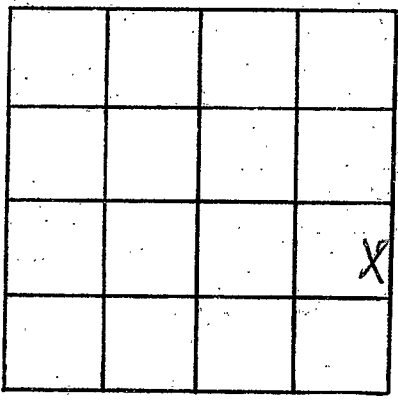

SECTION 22

Please indicate well location X.

ADDITIONAL INFORMATION

Lined area for additional information.

If more than one screen, show locations of each on sketch.