

Wayne
M 2015
6-8-79
June 8

MISSISSIPPI
BOARD OF WATER COMMISSIONERS
416 North State Street
Jackson, Mississippi 39201

WATER WELL DRILLERS LOG

McLWAIN WATER WELL SERVICE WAYNE

date well completed

1979

Box 37

county well located

WAYNESBORO, MISS. 39367

LANDOWNER:

ALTON PIPPENS

Waynesboro Miss
(mailing address)

WELL LOCATION:

2 sec 4 T 8 N R 8 E
5 1/2 miles SW of Whistler
(distance) (direction) (nearest town)

WELL PURPOSE:

Home
(home, irrigation, municipal, industrial)

WELL COMPLETION DATA:

- (1) diameter (inches) 2"
- (2) total depth (feet) 122'
- (3) static water level (feet) 69' below top of ground.
- (4) casing PVC, 117' (material) (depth)
2" (size) if telescope see back.
- (5) screen 5' 117' (length) (depth to top)
2" PVC, 008 (size) (material)
- (6) pump 1 7/2 (HP) (yield gpm)
220 AC (type power)
- (7) electric log No (yes or no)
(organization running log)
- (8) how well bottom plugged

DRILLERS REMARKS:

description of formations encountered

from to

SAND	0	5
SANDY CLAY	5	8 1/2
SAND	8 1/2	25
CLAY	25	59
FINE SAND & CLAY	59	62
Blue CLAY	62	71
SAND & CLAY	71	76
CLAY	76	90
FINE SAND	90	93
CLAY	93	102
FINE SAND & CLAY	102	110
Med. SAND	110	122


Miss. Board of Water Comm.

JUN 14 1979

RECEIVED

If well telescopes please sketch and show depths.

GROUND LEVEL

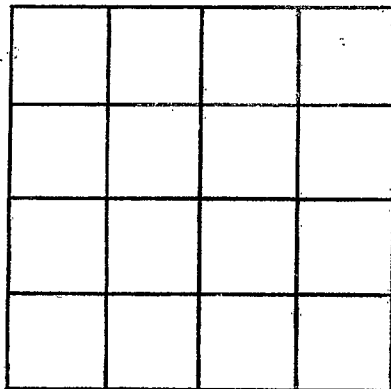

SECTION _____

Please indicate well location X.

ADDITIONAL INFORMATION

If more than one screen,
show locations of each on sketch.