

Wayne
M 2007
11-6-80

MISSISSIPPI
BOARD OF WATER COMMISSIONERS
416 North State Street
Jackson, Mississippi 39201

WATER WELL DRILLERS LOG

Nov 6 1980 80 Roy U. West Dr 1g Wayne
date well completed firm name county well located

This location 6.1 miles away

LANDOWNER:

Pitts

description of formations encountered

from to

sandy clay
CLAY
SAND

0 15
1.5 6.5
6.5 88

(mailing address)

WELL LOCATION:

sec 5 T 8 N 5 R 8 E W
12.6 miles W of Waynesboro
(distance) (direction) (nearest town)

WELL PURPOSE:

HOME
(home, irrigation, municipal, industrial)

WELL COMPLETION DATA:

- (1) diameter (inches) 2 1/2
- (2) total depth (feet) 88'
- (3) static water level (feet) 55' below above top of ground.
- (4) casing PVC, 83'
(material) (depth)
(size) If telescope see back.
- (5) screen 5', 83'
(length) (depth to top)
1/4, stainless steel
(size) (material)
- (6) pump 1 8
(HP) (yield gpm)
REA
(type power)
- (7) electric log NO
(yes or no)
(organization running log)
- (8) how well bottom plugged WASH VALEU

DRILLERS REMARKS:


DEPT. OF NATURAL RESOURCES
BUREAU OF LAND & WATER RESOURCES

NOV 24 1980

RECEIVED

If well telescopes please sketch and show depths.

GROUND LEVEL

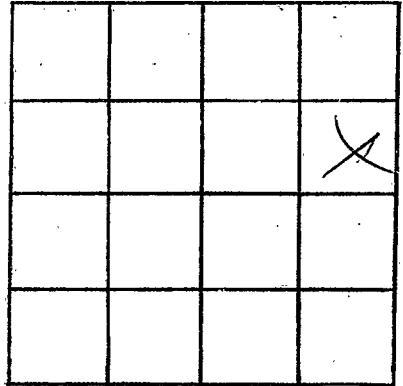

SECTION _____

Please indicate well location X.

ADDITIONAL INFORMATION

If more than one screen, show locations of each on sketch.